


RECEIVED

MAR 30 2008
WATER RESOURCES DEPT
SALEM OREGON

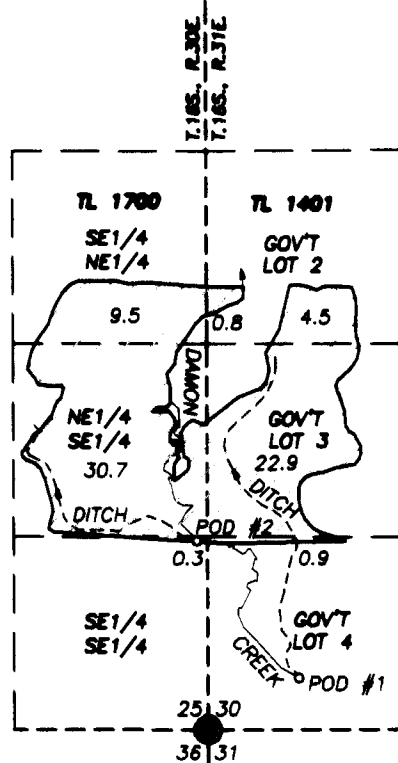

SCALE 1"=1320'

FINAL PROOF SURVEY
UNDER PERMIT NO. 51971
FOR IRRIGATION AND LIVESTOCK WATERING
IN NAME OF
DRC LAND COMPANY, LLC
BY

ROBERT D. BAGETT
P.O. BOX 476
JOHN DAY, OR. 97845
(541) 575-1251

SURVEY COMPLETED NOVEMBER 25, 2008

POD #1 IS 350' N. AND 620' E. OF THE SE COR.
SECTION 25, T.16S., R.30E., W.M. MEASURING DEVICE
IS 20' DOWNSTREAM OF POD

POD #2 IS 1300' N. AND 80' W. OF THE SE COR.
SECTION 25, T.16S., R.30E., W.M. MEASURING DEVICE
IS 40' DOWNSTREAM OF POD



PLACE OF USE



FOUND ALUMINUM CAP MONUMENT

NOTE: THE PREPARATION OF THIS MAP
WAS FOR THE PURPOSE OF IDENTIFYING
THE LOCATION OF THE PROPOSED WATER
RIGHT AND HAS NO INTENT TO PROVIDE
DIMENSIONS OR LOCATION OF PROPERTY
OWNERSHIP LINES.

