

T. 5 S., R. 10 W., W.M.

LOCATION: THE NORTHWEST QUARTER OF SECTION 19,
TOWNSHIP 5 SOUTH, RANGE 10 WEST, WILLAMETTE MERIDIAN,
TILLAMOOK COUNTY, OREGON.

DATE: 18 OCTOBER 2010 TAX LOT: 5S1019B-1500

13 18

SECTION 18

24 19

SECTION 19

LEGEND:

- . . . — = Property line
- — — — = Section line
- — — — = "40" line
- — — — = Waterline



SECTION 24

SECTION 19

POINT OF DIVERSION. SUMP WELL
#1 ON EDGE OF CREEK
SURROUNDED BY GRAVEL FISH
SCREEN 1428 FEET SOUTH &
1458 FEET EAST OF THE NW
CORNER OF SECTION 19.

PLACE OF USE. 2257.84
FEET SOUTH AND 1728.54
FEET EAST OF THE NW
CORNER OF SECTION 19.


NE 1/4 OF
THE NW 1/4

POWER POLE
I certify that the information I have
provided in this final proof survey is an
accurate representation of the proposed
water use and is true and correct to
the best of my knowledge. It is to be
used for the purpose of identifying the
location of water right only and is not
intended to provide legal dimensions or
locations of property ownership lines.

Nathan Magness

NATHAN MAGNESS, CWRE 60087

By : MAGNESS LAND SURVEYING
PO BOX 1239
WILLAMINA, OREGON, 97396
Cell : 971-237-3413
E-Mail : MAGNESS@WBCABLE.NET

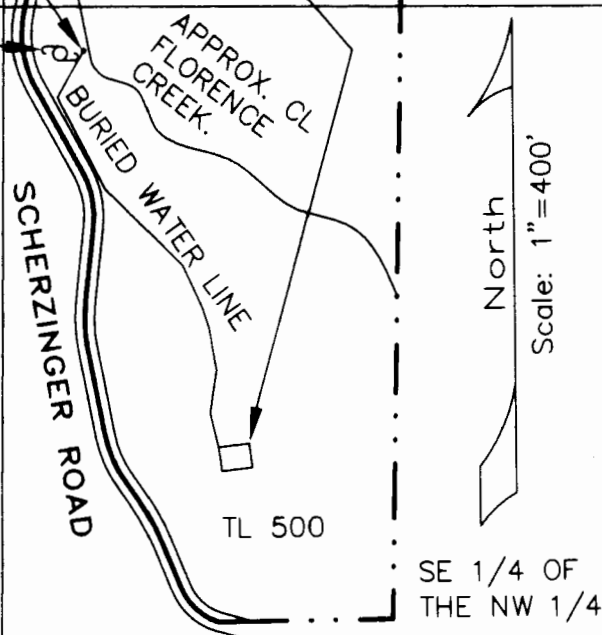

FINAL PROOF SURVEY

UNDER

Application No. S-71822 Permit No. S-52072

IN NAME OF

DONATO JAMES MEZZENGA

Surveyed September 23, 2010