

W.M. 0365

$$1'' = 400'$$

SEE MAP 4 5 17

PREPARED FOR
PURPOSE ONLY

SEE MAP 4 5 19

40.2

Application No. R 84006
Permit No. R12664


RECEIVED BY OWRD

OCT 20 2014

SALEM, OF:

2099.1

THE VICKERYS

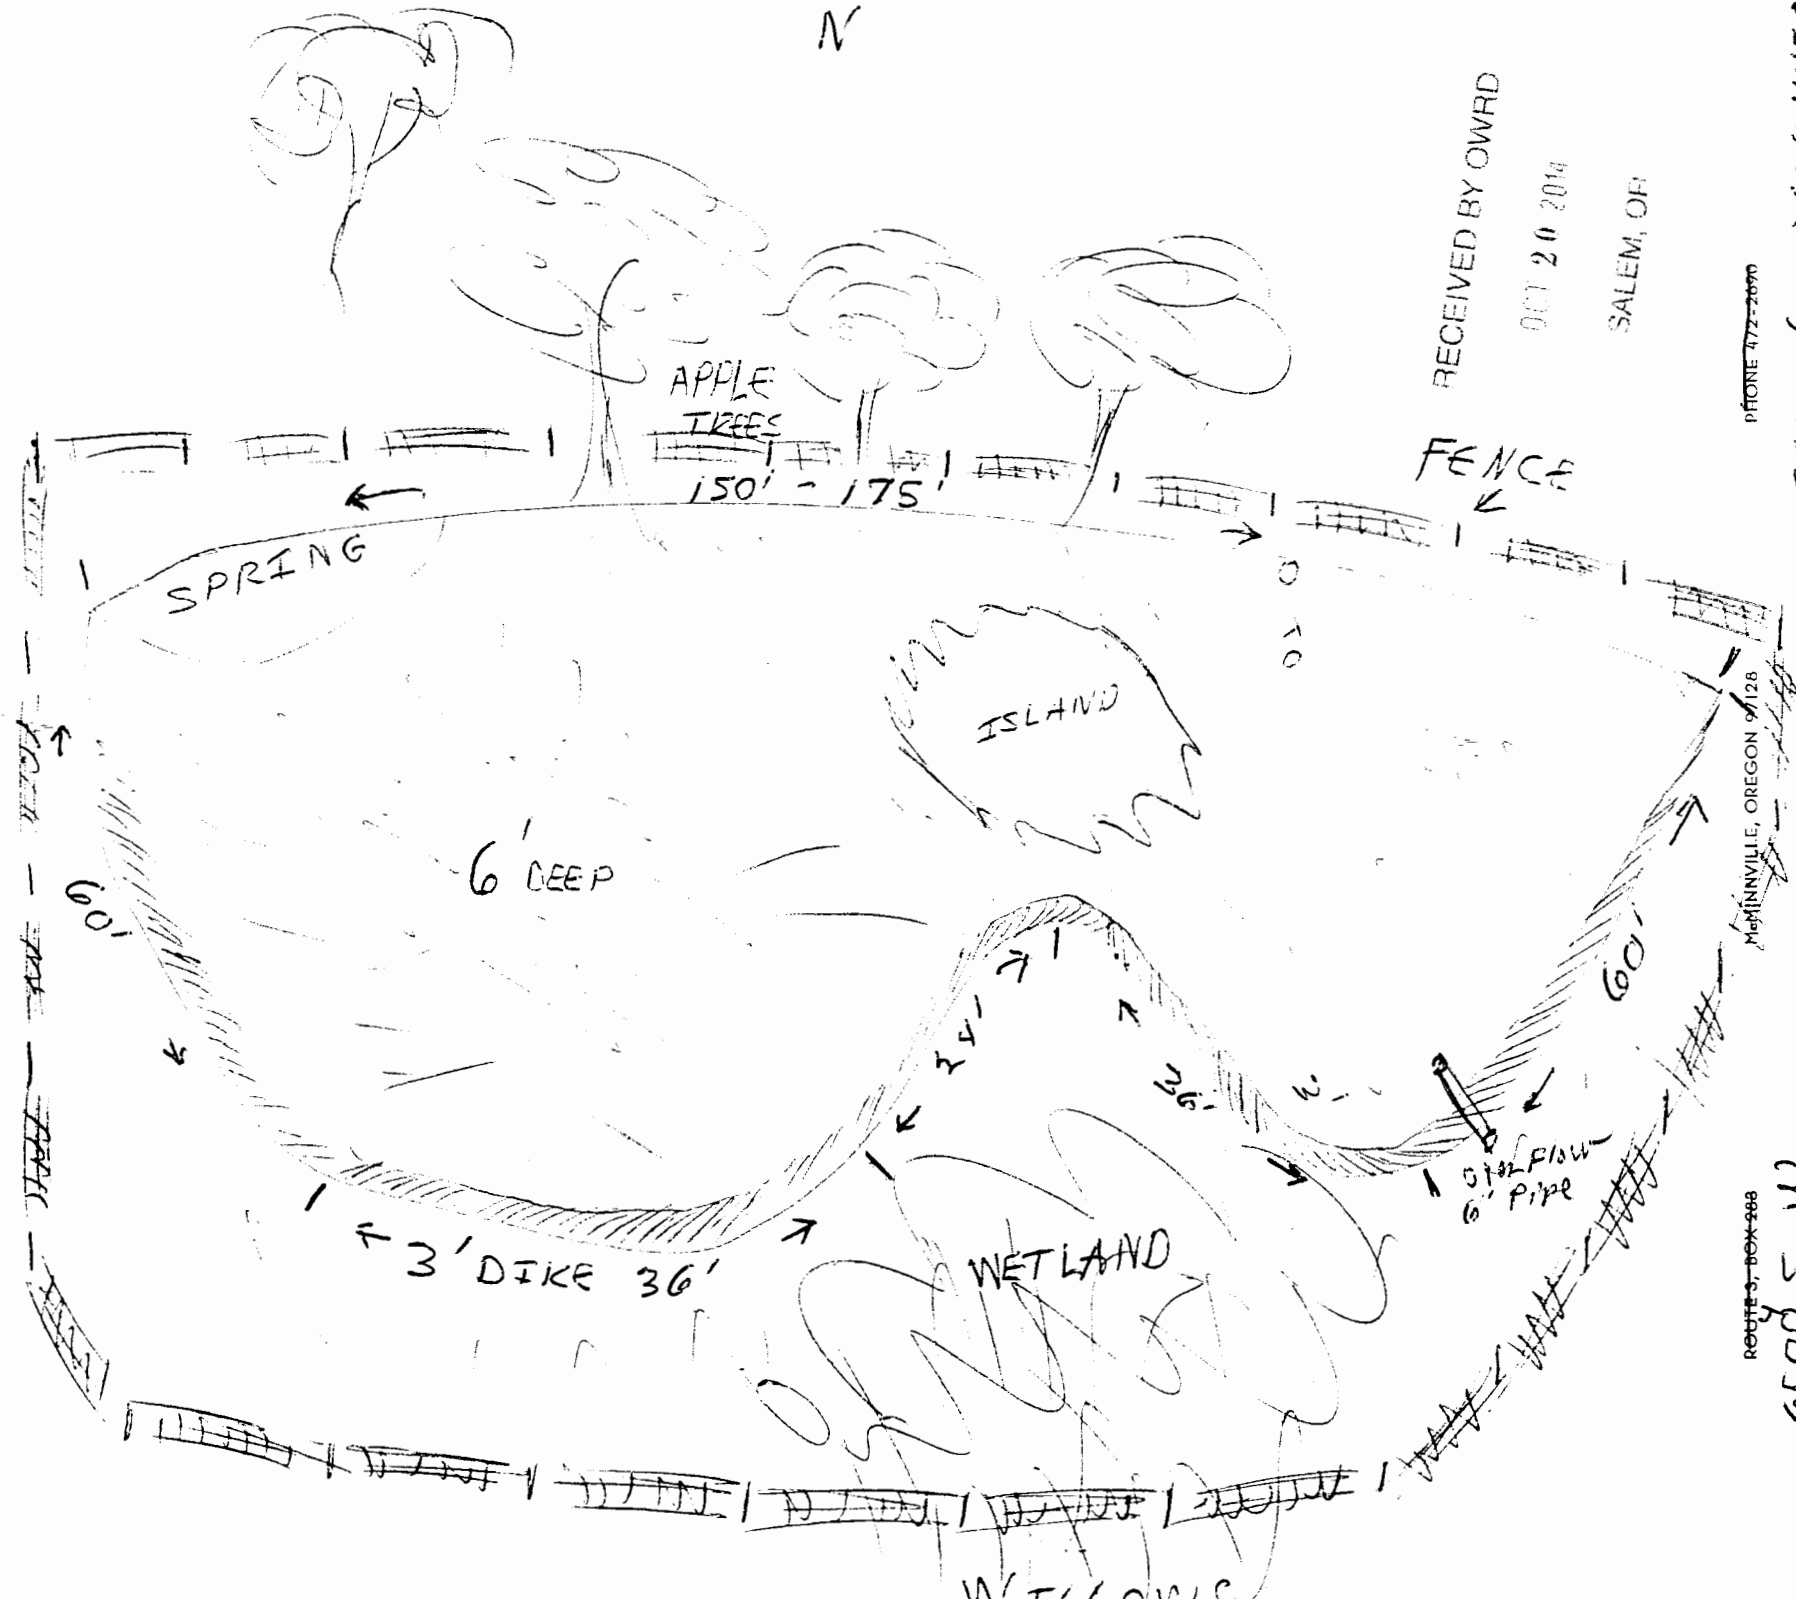

RECEIVED BY OWRD

OCT 20 2014

SALEM, OR

PHONE 477-2090

McMINNVILLE, OREGON 97128

ROUTE 3, BOX 988

6500 S.W.
1st OLD RD

GEO. R. (503) 638-4450
474 0368