

CLAIM OF BENEFICIAL USE



Application No. S70379 – Permit No. S52475



Applicant: Turner Brothers Land & Livestock
375 Noble Road
Ontario, OR 97914

Scale 1" = 1320'

Tax Lot No.: 16S 47 B 4400
County: Malheur
River Basin: Snake

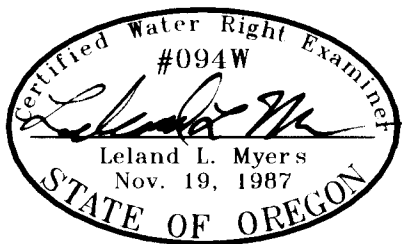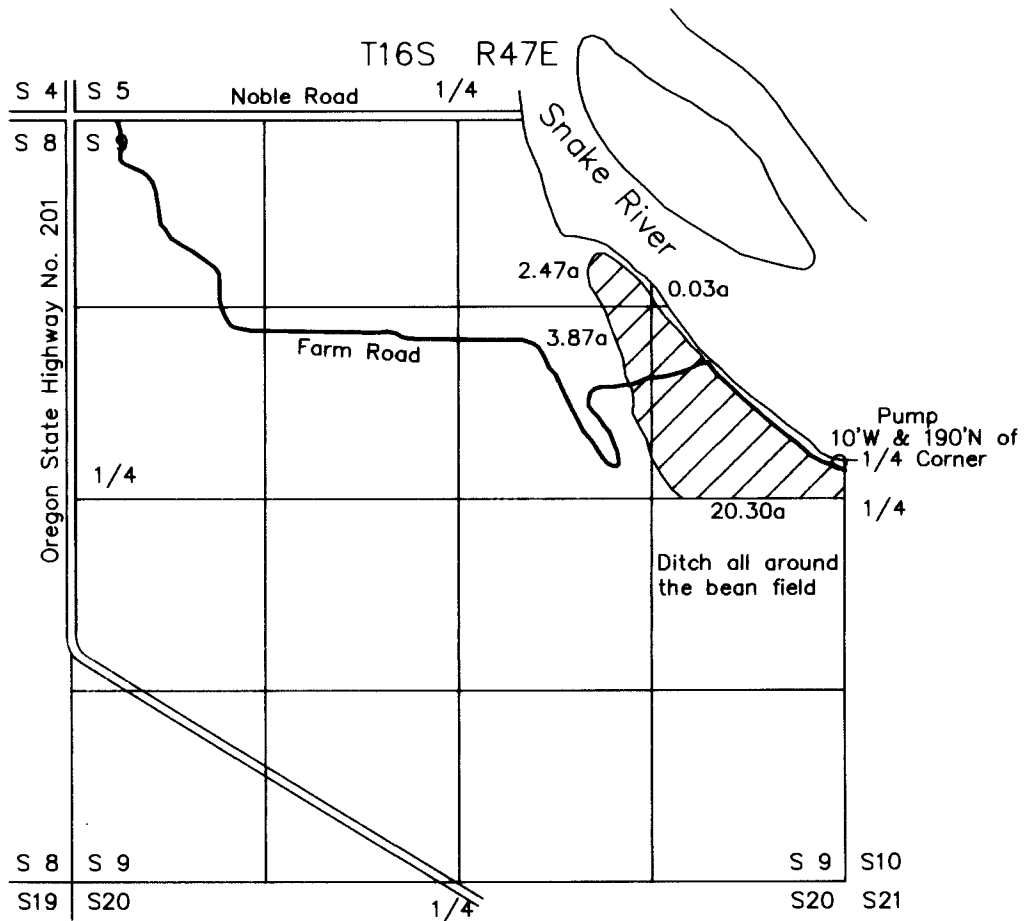

This map is for the purpose of identifying the location of the water right only and has no intent to provide dimensions or location of property ownership lines.