

COBU MAP # 894

CLAIM OF BENEFICIAL USE MAP




FOR

DEL EDWARDS

LOCATED IN

NE 1/4 SEC. 6, T. 10 S., R. 3 W., W.M.,
AND THE SE 1/4 SEC. 31 AND THE SW 1/4
SEC. 32, T. 9 S., R. 3 W., W.M.
LINN COUNTY, OREGON

FEBRUARY 11, 2015

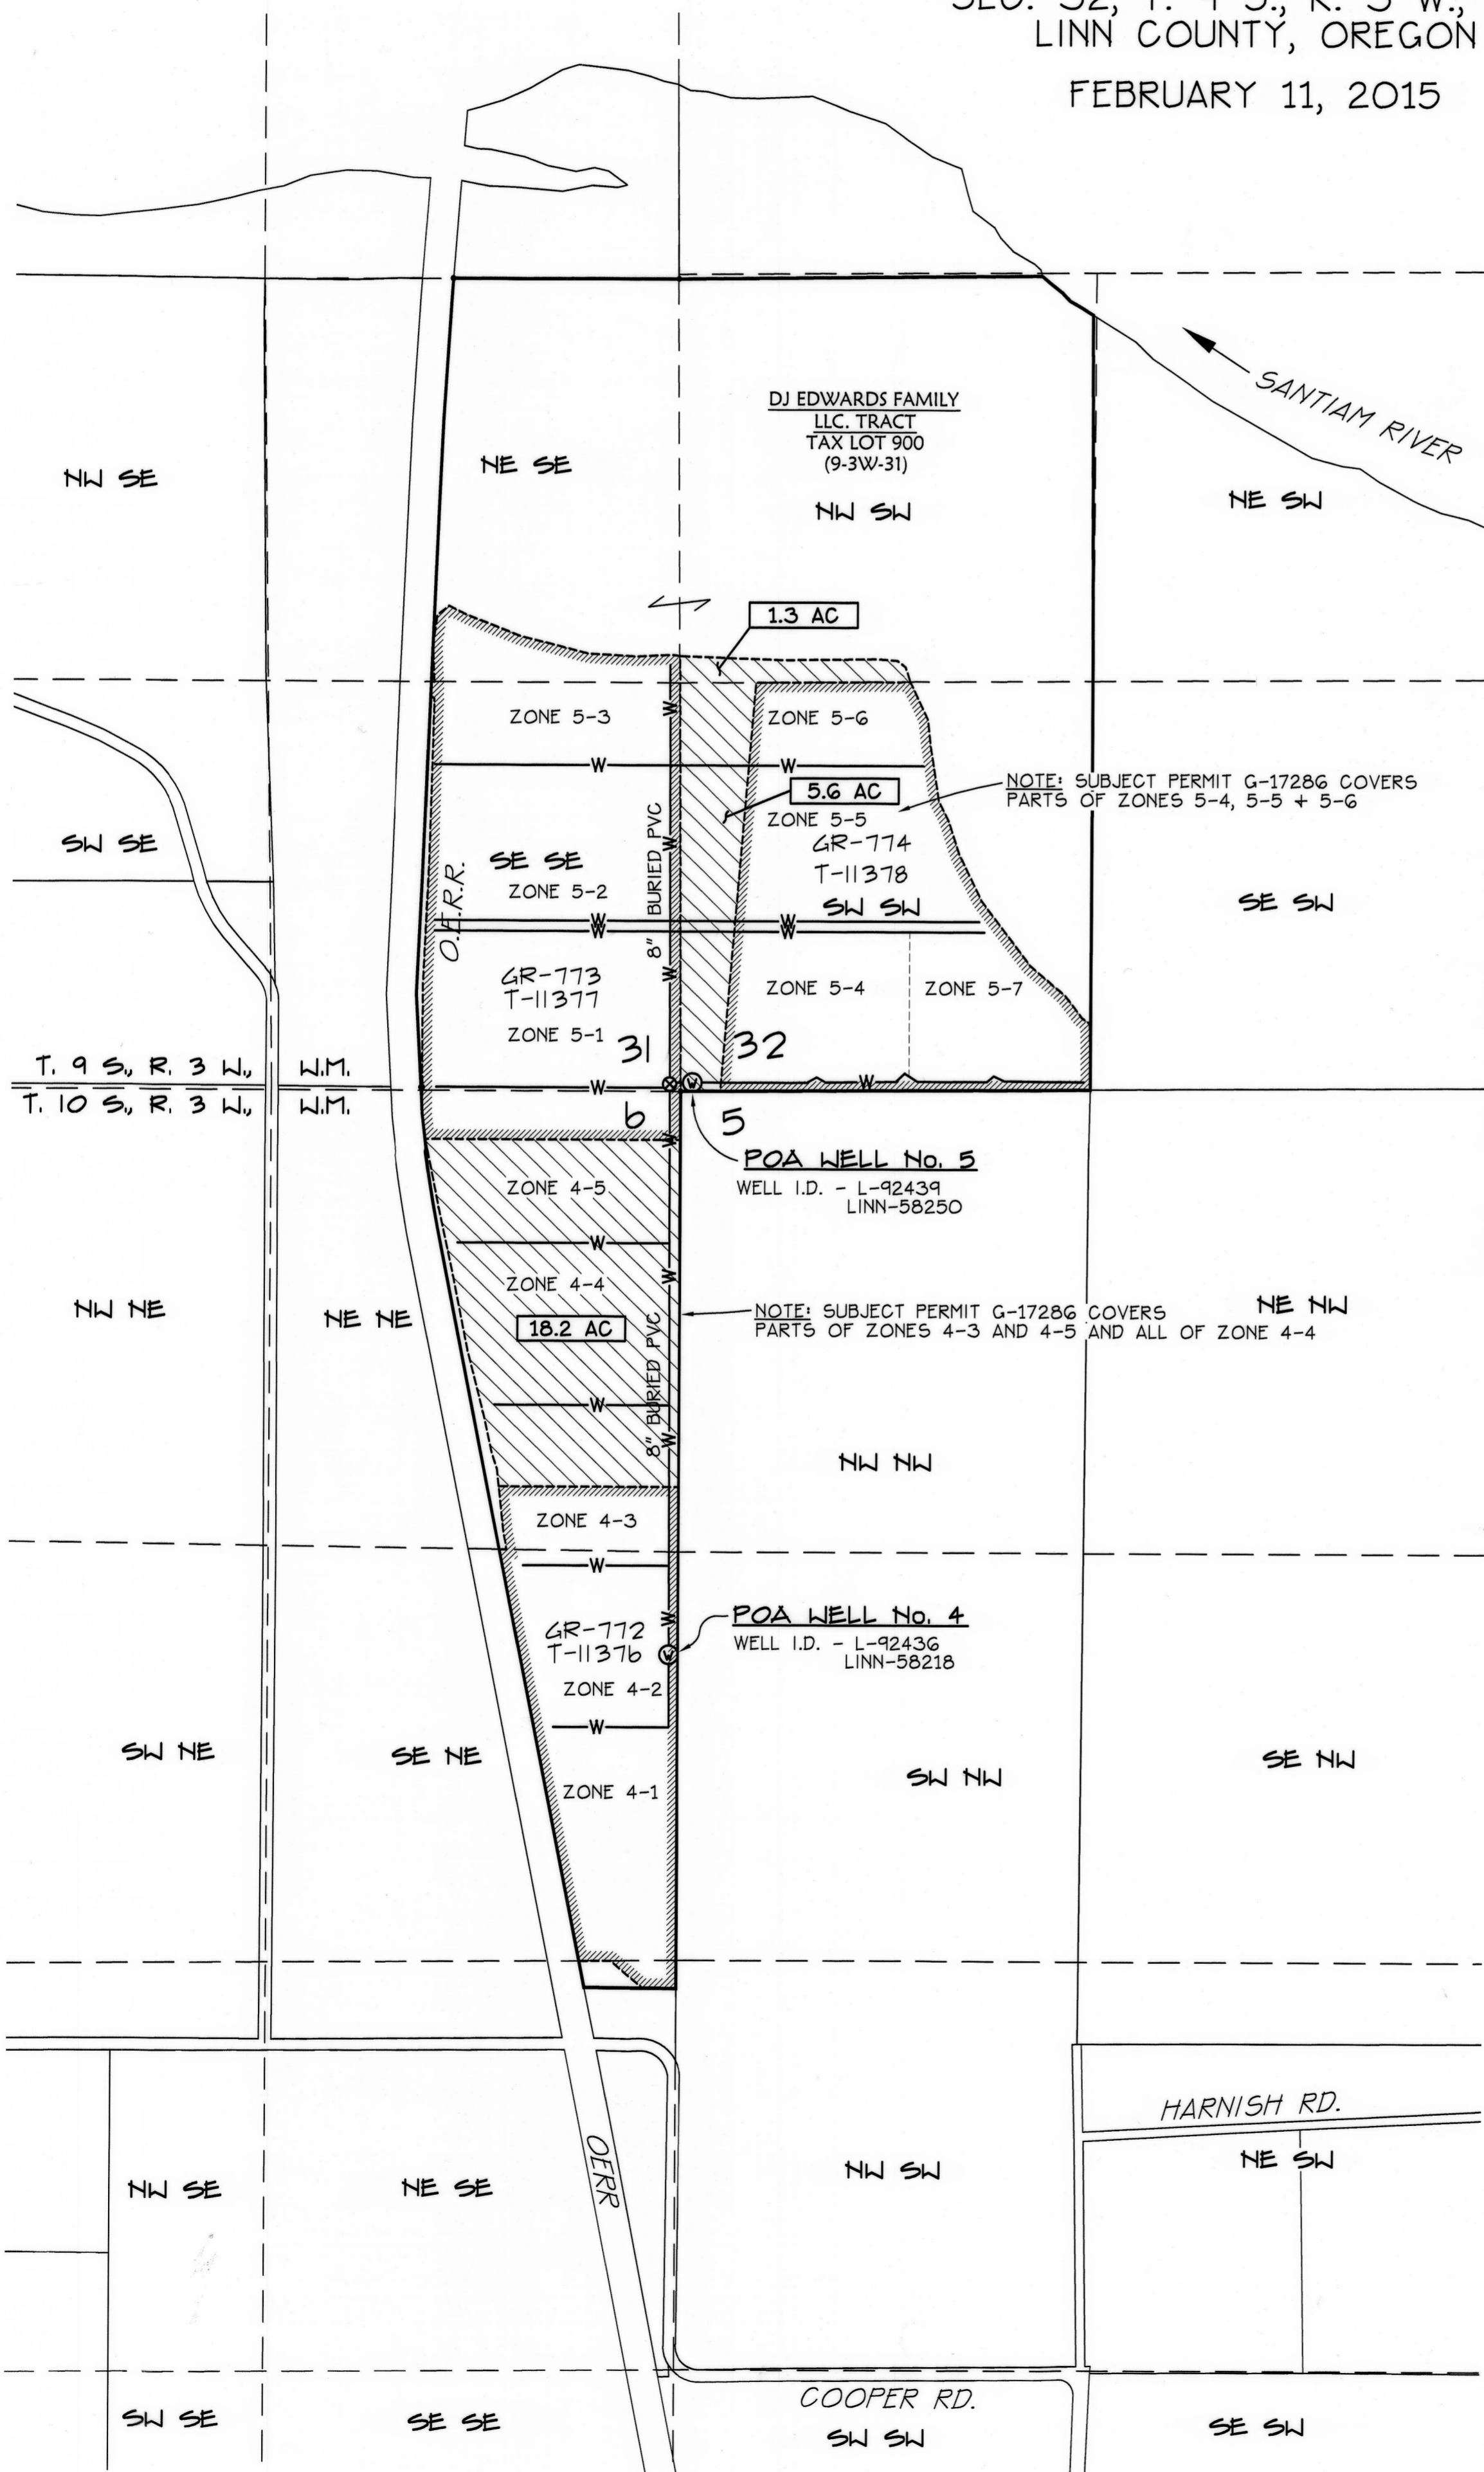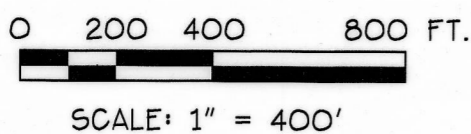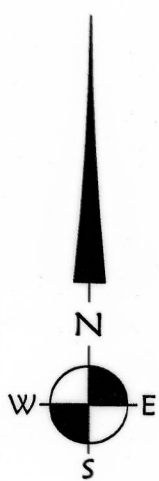

APPLICATION No. G-17541
PERMIT No. G-17286

OWNER:

DJ EDWARDS FAMILY, LLC.
32633 COOPER DR. NE
ALBANY, OR 97321





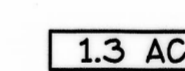
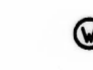
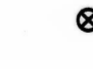
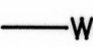
APPLICANT:

DEL EDWARDS, MANAGING MEMBER OF
D.J. EDWARDS FAMILY TRUST, LLC.
32633 COOPER DR. NE
ALBANY, OR 97321

TAX LOT:

900 (9-3W-31)

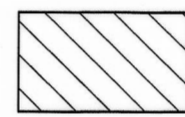LEGEND:


-  PROPOSED PRIMARY IRRIGATION
25.1 IRRIGATED ACRES
-  WATER RIGHTS UNDER GR-772 AS NOTED. THE LOCATION SHOWN IS FOR MODIFICATION OF GR-772 THAT HAS BEEN ASSIGNED APPLICATION T-11376.
-  WATER RIGHTS UNDER GR-773 AS NOTED. THE LOCATION SHOWN IS FOR MODIFICATION OF GR-773 THAT HAS BEEN ASSIGNED APPLICATION T-11377.
-  WATER RIGHTS UNDER GR-774 AS NOTED. THE LOCATION SHOWN IS FOR MODIFICATION OF GR-774 THAT HAS BEEN ASSIGNED APPLICATION T-11378.
-  PROPOSED PRIMARY WATER RIGHT
IRRIGATED ACERAGE PER 1/4 1/4 SECTION
-  POA WITH METER
-  GATE VALVE
-  BURIED IRRIGATION LINE

GOVERNMENT TIES:

TIE FROM GOVERNMENT CORNER AT NE CORNER
SECTION 6, T. 10 S., R. 3 W., W.M.
POA #4 1815' SOUTH + 20' WEST
POA #5 30' NORTH + 40' EAST

DISCLAIMER:

THIS MAP IS NOT INTENDED TO
PROVIDE LEGAL DIMENSIONS OR
LOCATIONS OF PROPERTY
OWNERSHIP LINES

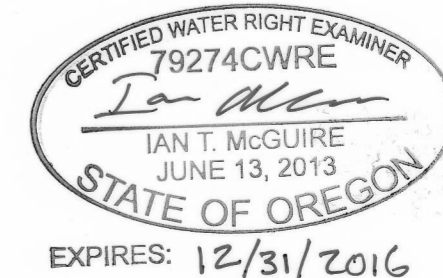

EXPIRES: 12/31/2016

RECEIVED

MAR 16 2015

Date: 2/11/2015 Time: 11:06
Scale: 1=400(P5)
File: dwg\2011\11-49\11-49a-wr-cobu.dwg (lan)

WATER RESOURCES DEPT
SALEM, OREGON

K & D ENGINEERING, Inc.
276 N.W. Hickory Street P.O. Box 725
Albany, Oregon 97321
(541) 928-2583