
 Lands with primary rights from new well.
 Mainline

RECEIVED

JUL 2 2007

WATER RESOURCES DEPT
SALEM, OREGON


June 25, 2007

**FINAL PROOF MAP FOR
WATER RIGHTS FROM A
NEW WELL
FOR**

**RUSSELL BINGAMAN
BY**

**BAGETT - GRIFFITH & BLACKMAN
2006 ADAMS AVENUE
LAGRANDE, OREGON 97850**

APPLICATION NO. G-15950
PERMIT NUMBER G-15518

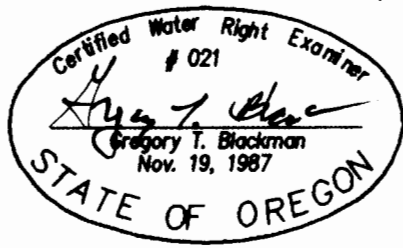

NOTE: The preparation of this map was for the purpose of identifying the location of the proposed water right and has no intent to provide dimensions or location of property ownership lines. Location information shown hereon was furnished by the applicant.