

Claim of Beneficial Use Map

By

Dennis Farmer


Application S-86376, Permit S-54246

T 36 S, R 3 W, Section 10, W.M.

RECEIVED


JUN 27 2007

WATER RESOURCES DEPT
SALEM, OREGON

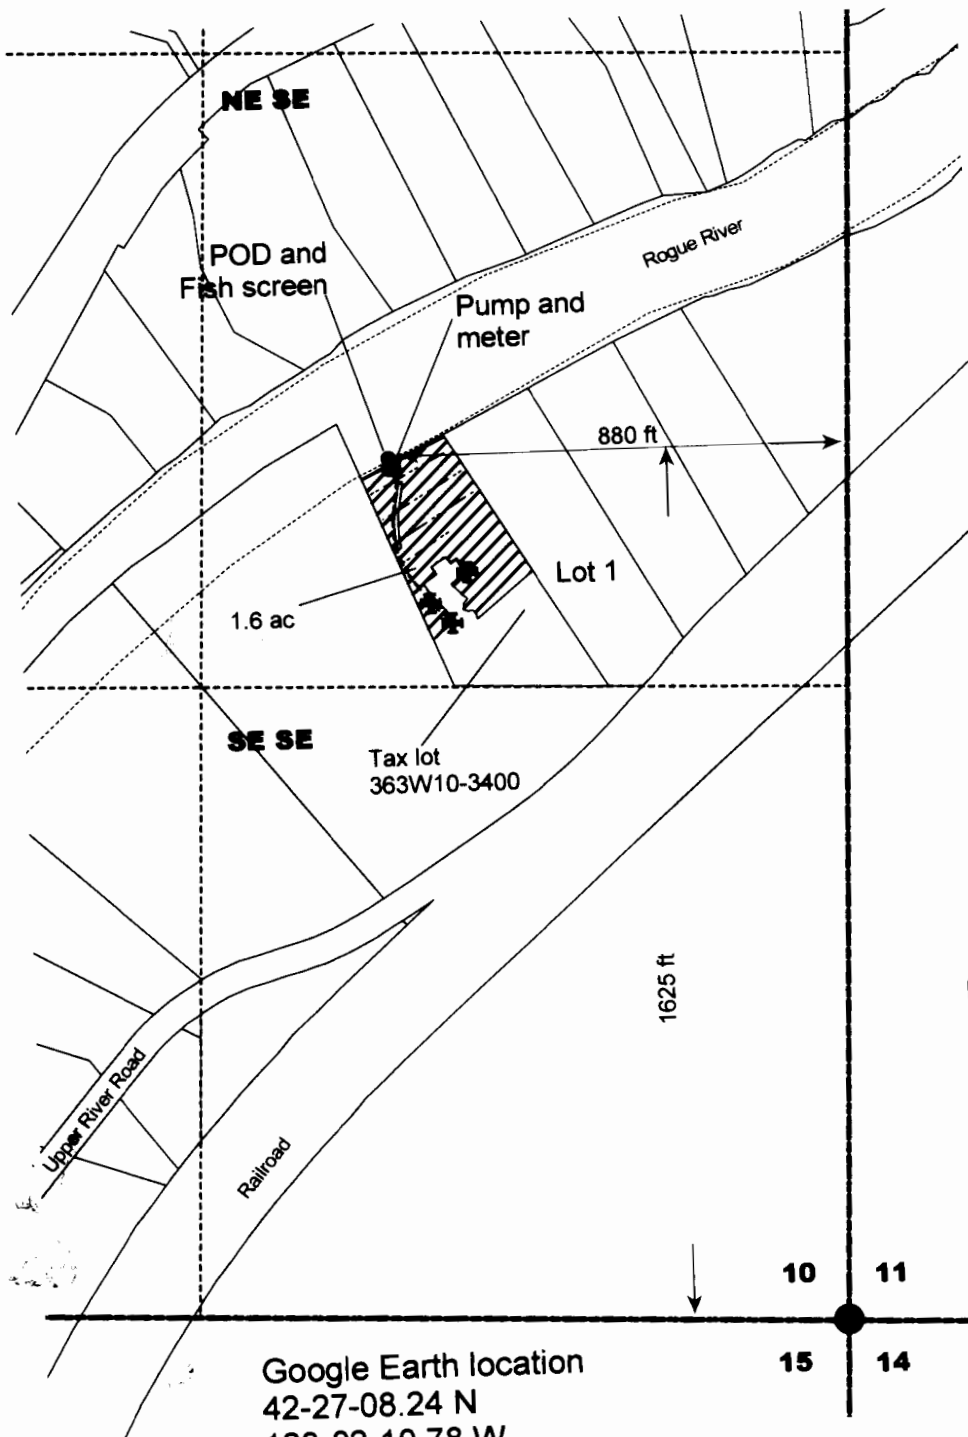


Legend

- Area irrigated
- Point of Diversion
- Pump and meter location
- 2 inch main line
- 1 1/4 inch laterals
- Hose bib
- Section line
- Quarter-quarter line

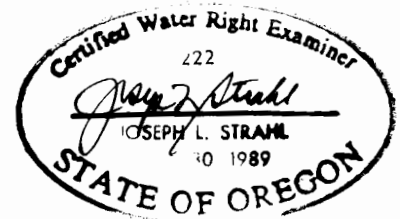

CWRE stamp

Note: this map is for water right purposes only. It is not to be used for property line location

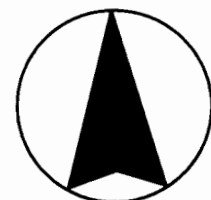

Scale 1" = 400'