
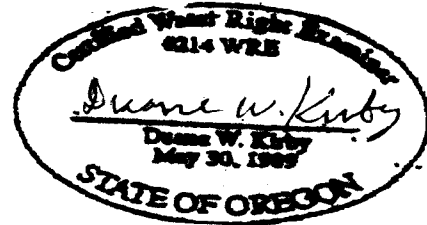


CLAIM OF BENEFICIAL USE
 FOR: ED AND RICHARD SANTOS
 T22S, R5W WM SEC 14
 BY DUANE W. KIRBY
 APPLICATION NO S-72419
 PERMIT NO S-51889
 TAX LOT 400

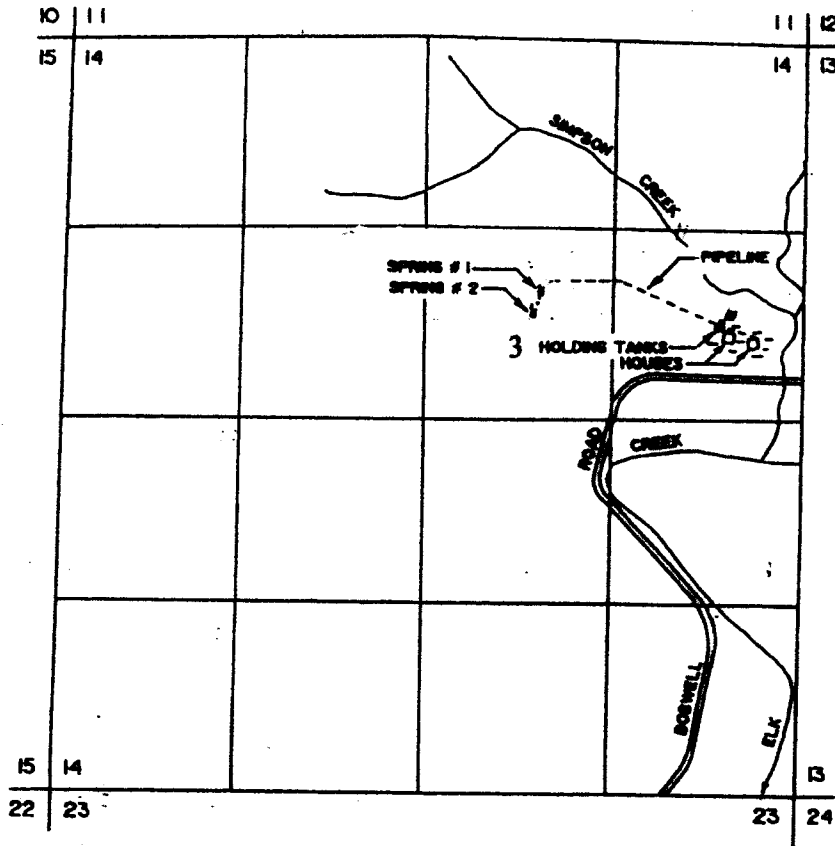

SPRING #1 IS LOCATED 870 FEET NORTH AND 1790 FEET WEST, AND SPRING #2 IS LOCATED 720 FEET NORTH AND 1840 FEET WEST FROM THE EAST 1/4 CORNER OF SECTION 14, BOTH BEING WITHIN THE SE 1/4 OF THE NE 1/4 OF SECTION 14, TOWNSHIP 22 SOUTH, RANGE 5 WEST, W.M., DOUGLAS COUNTY.

THE PURPOSE OF THIS MAP IS TO IDENTIFY THE LOCATION OF THE WATER RIGHT. IT IS NOT INTENDED TO PROVIDE INFORMATION RELATIVE TO THE LOCATION OF PROPERTY OWNERSHIP BOUNDARY LINES.

RECEIVED
 OCT 20 2010
 WATER RESOURCES DEPT
 SALEM, OREGON