



TOWNSHIP 13 SOUTH, RANGE 5 WEST, W.M.

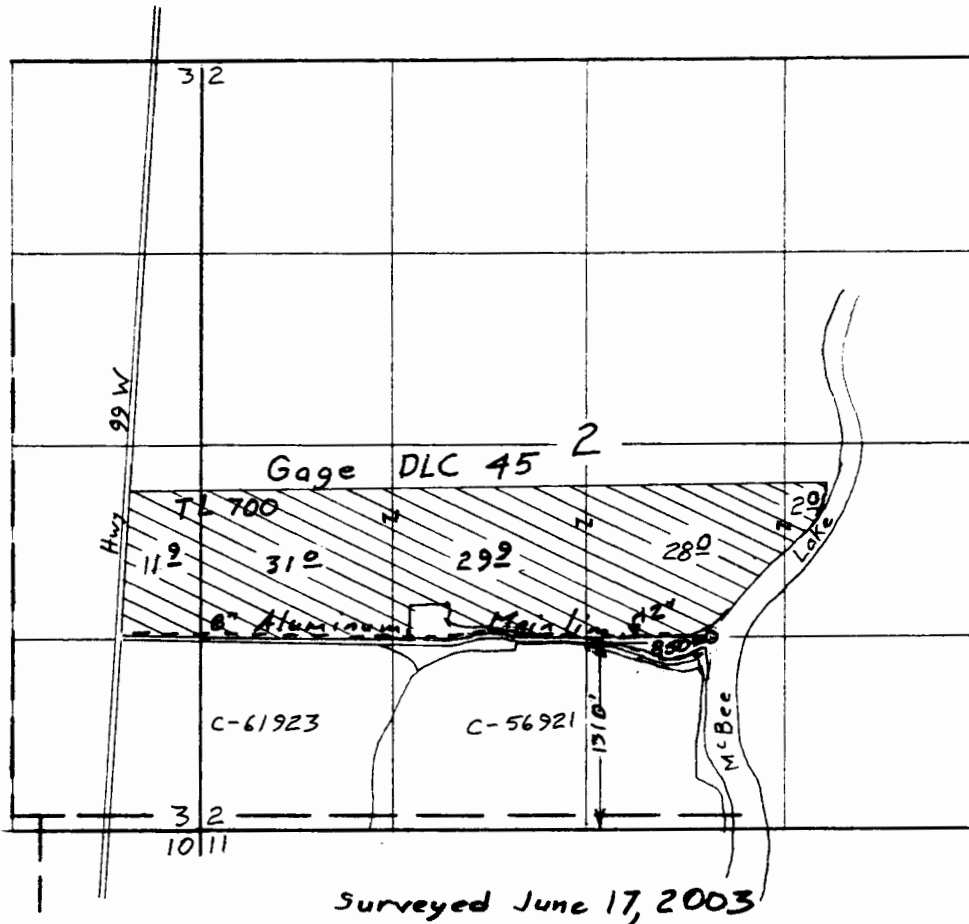

Claim of Beneficial Use Map
for
VENELL FARMS, INC.

App S-81954
Per 53360

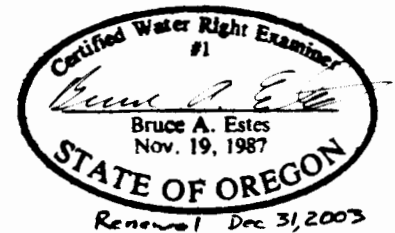

This map is for the purpose of locating a water right only and has no intent to provide legal dimensions or the location of property lines.

ESTES SURVEYS, LLC

6293 Sunnyview Rd. NE 60382 Arnold Rd.
Salem, OR 97305 Bend, OR 97702
(503) 585-7593 (503) 382-7391