


TOWNSHIP 13 SOUTH, RANGE 5 WEST, W.M.

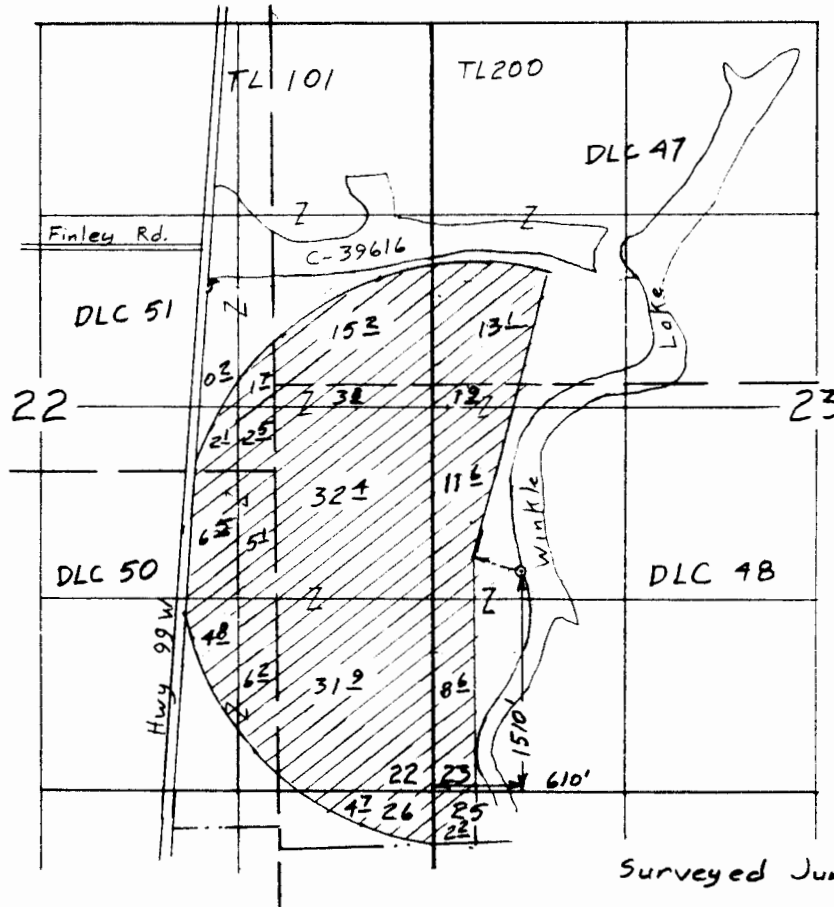


Surveyed June 17, 2003

Claim of Beneficial Use Map  
for  
VENELL FARMS, INC.

App S-81955

Per 53361

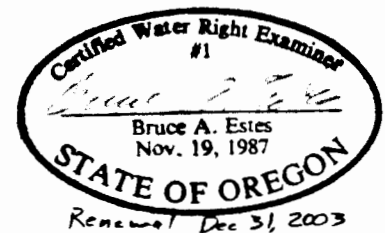

This map is for the purpose of locating a water right only and has no intent to provide legal dimensions or the location of property lines.

**ESTES SURVEYS, LLC**  
 6293 Sunnyview Rd. NE Salem, OR 97305 (503) 585-7593  
 60382 Arnold Rd. Bend, OR 97702 (503) 382-7391