


SITE PLANNING MAP FOR MOUNTAIN FARMS, LLC

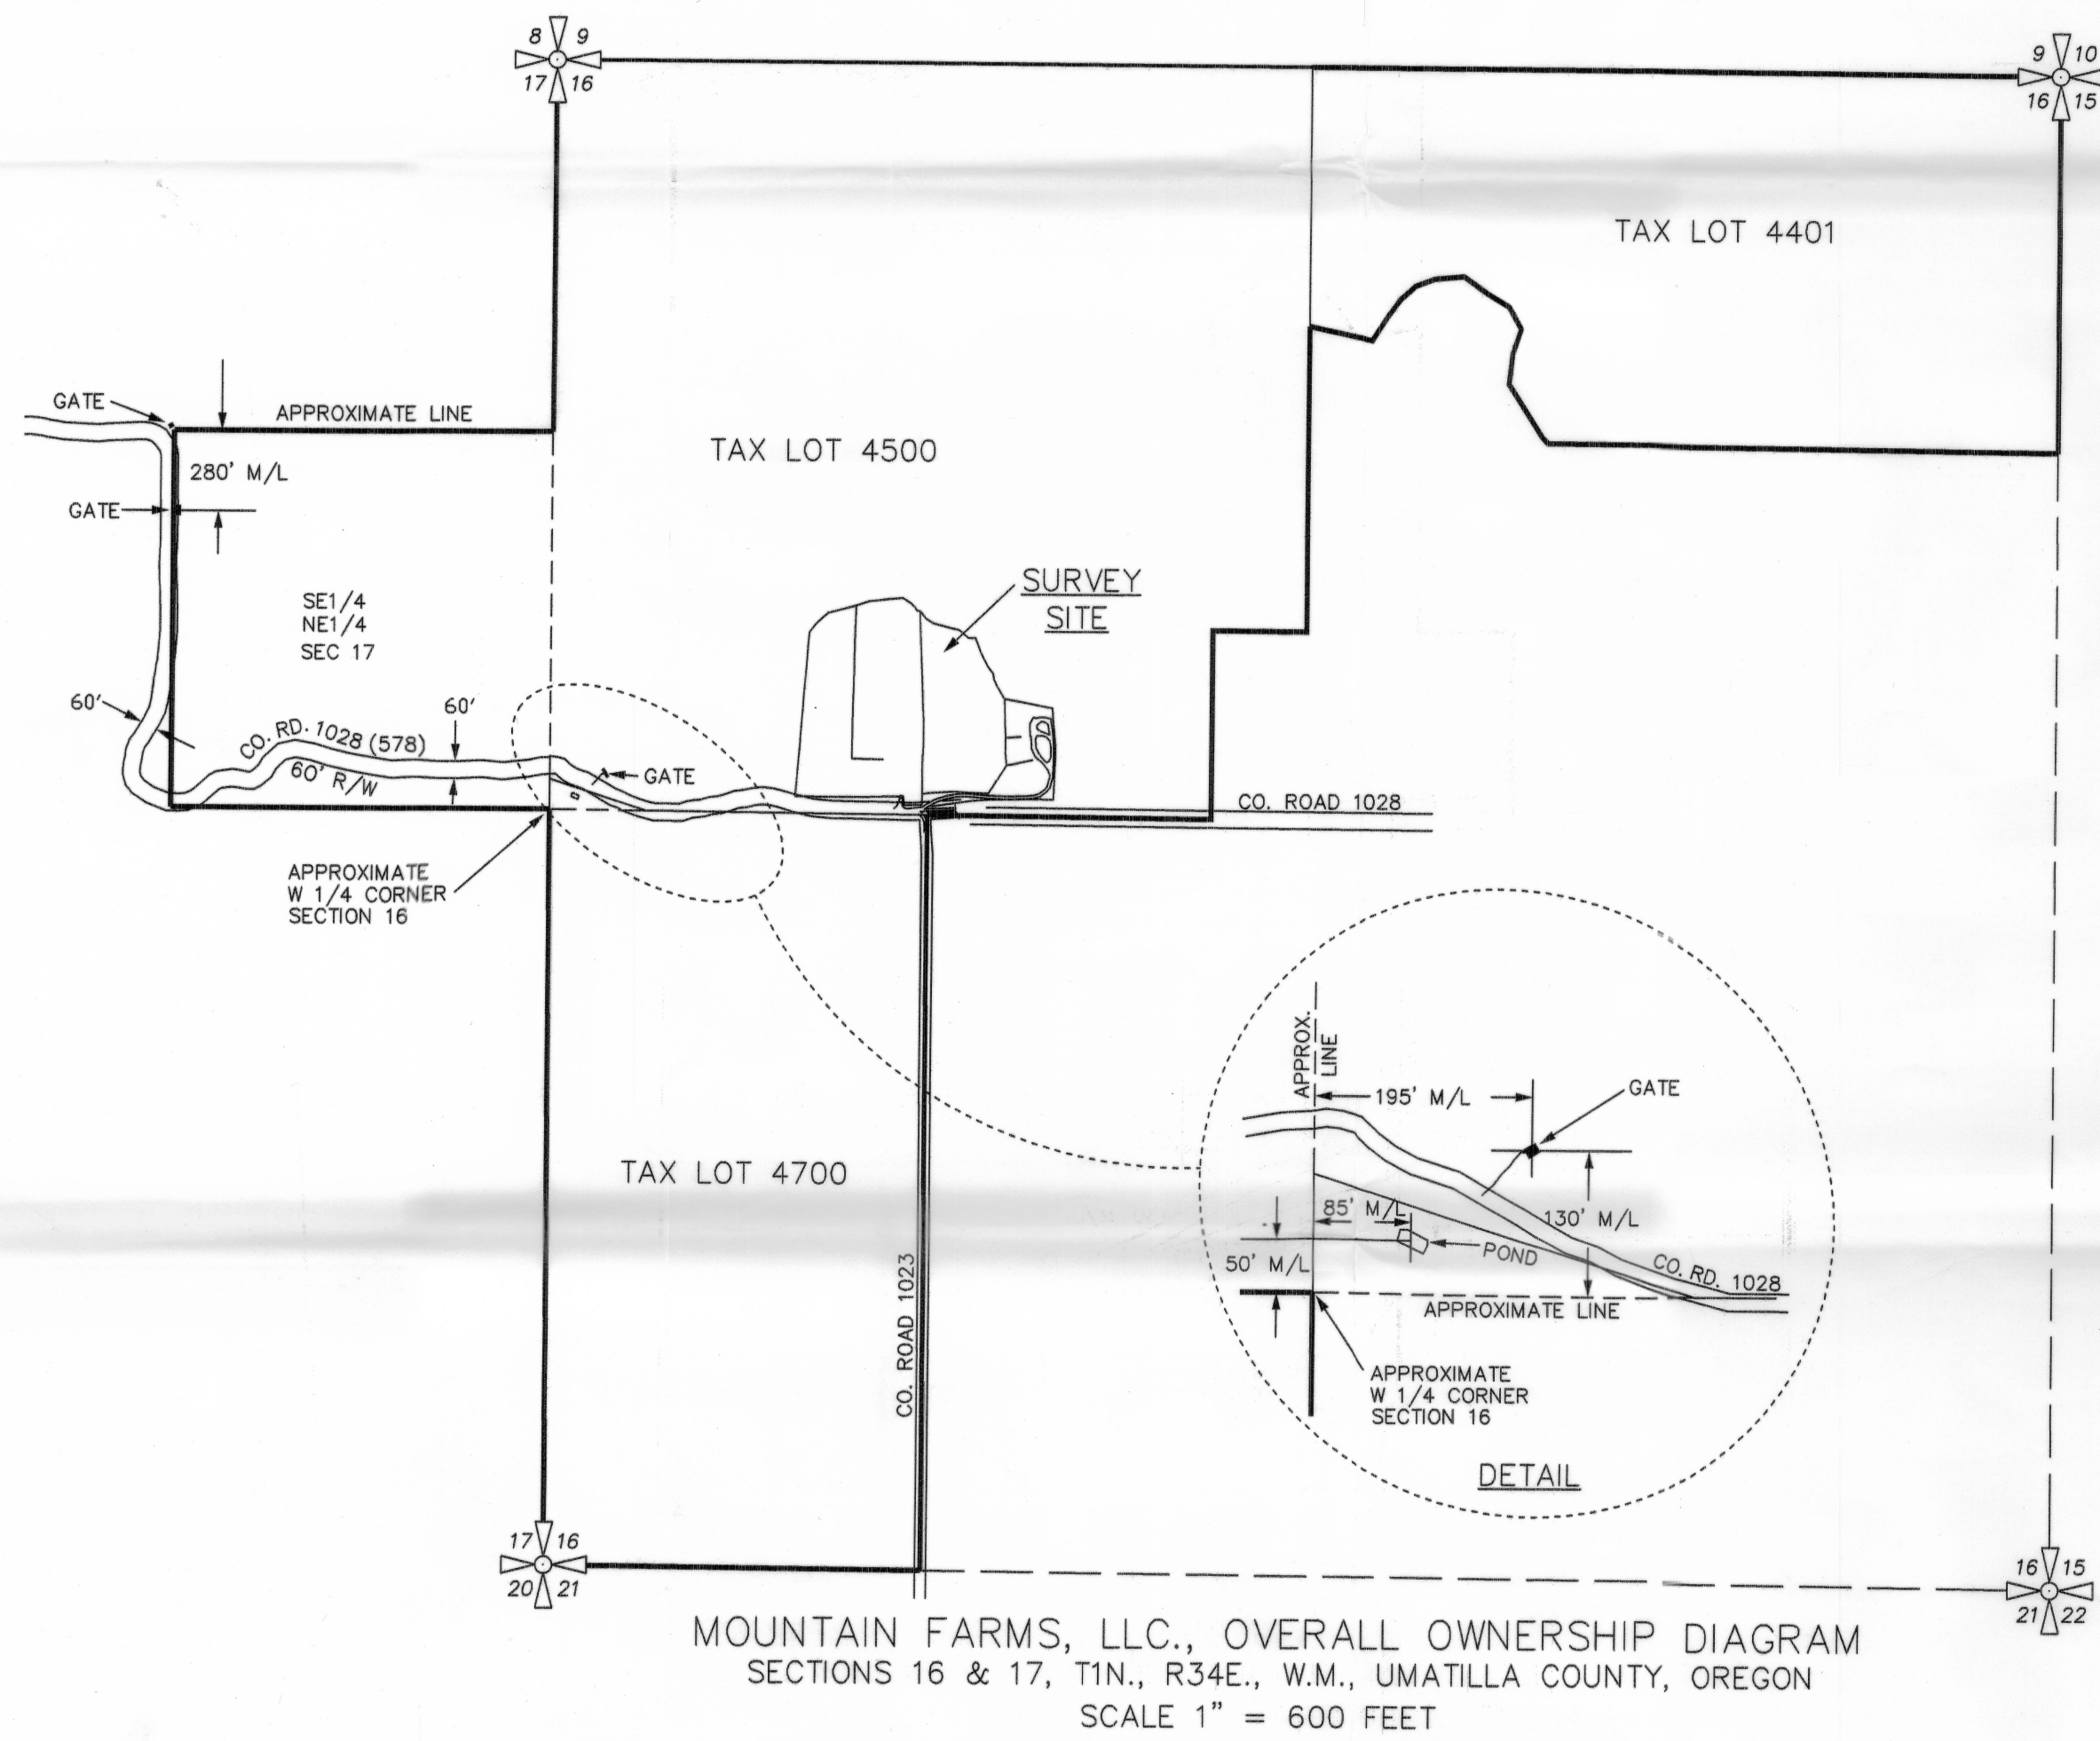


LEGEND

- x—x—x — EXISTING FENCELINE.
 —○—P— — POWER POLE.
 □T — TELEPHONE PEDESTAL.
 —P— — OVERHEAD POWER LINE.

NARRATIVE

THIS SURVEY WAS PERFORMED AT THE REQUEST OF MOUNTAIN FARMS, LLC.
THE SURVEY WAS MADE BY A 2 PERSON CREW USING A SOKKIA SET 48 FIVE
SECOND TOTAL STATION. OVERALL SITE BOUNDARY SHOWN IS APPROXIMATE.

NOTE:
THE COUNTY ROAD RIGHT-OF-WAY LINES IN
THIS AREA SHOWN CENTERED ON THE
CENTERLINE OF THE EXISTING COUNTY ROADS.

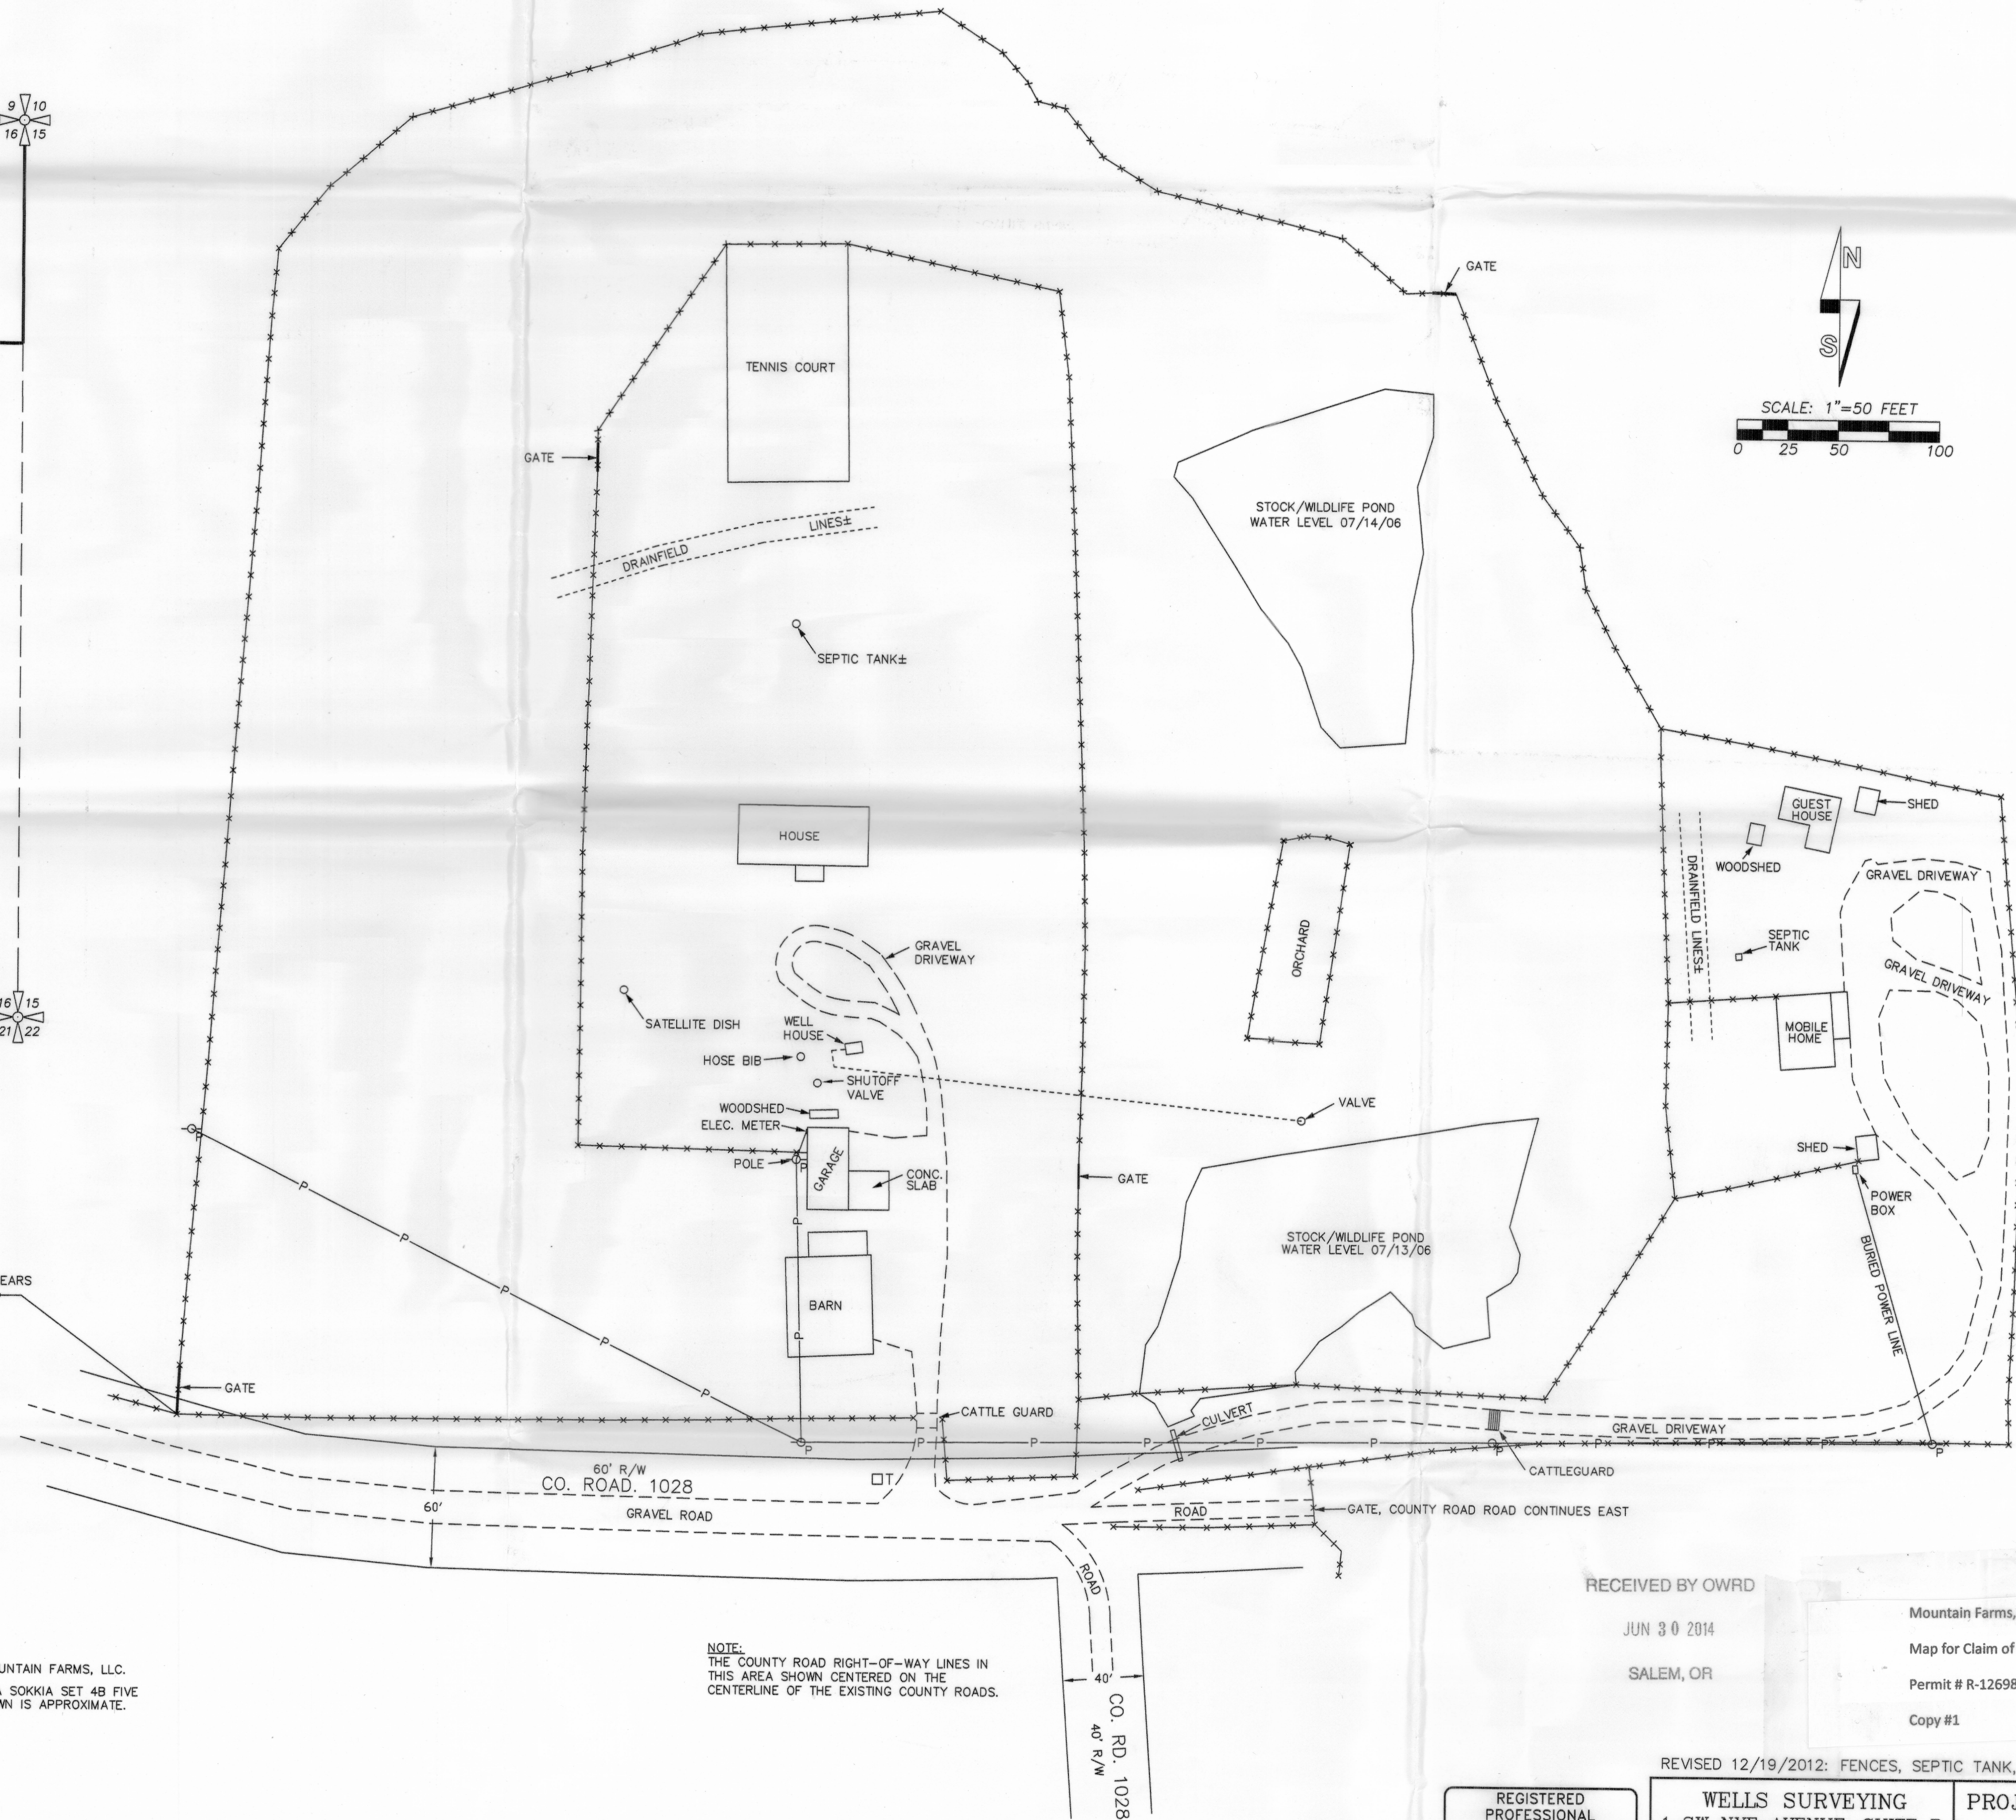

RECEIVED BY OWRD

JUN 30 2014

SALEM, OR

Mountain Farms, LLC

Map for Claim of Beneficial Use

Permit # R-12698

Copy #1

REVISED 12/19/2012: FENCES, SEPTIC TANK, CATTLEGUARD.

REGISTERED
PROFESSIONAL
LAND SURVEYOR

Will. R. Webb

OREGON
JULY 22, 1977
WILLIAM R. WELLS
1106
RENEWS 6/30/14

WELLS SURVEYING
1 SW NYE AVENUE, SUITE B
P.O. BOX 1696
PENDLETON, OREGON
PHONE: (541) 276-6362

DATE: 7/06	DR. BY: JMW/DMT
CK. BY: WRW	NO: 06-1055

PROJECT: \BETTYB2012

SITE SURVEY FOR:

MOUNTAIN FARMS, LLC

LOCATED IN THE SECTIONS 16 AND 17,
TOWNSHIP 1 NORTH, RANGE 34 EAST,
W.M., UMATILLA COUNTY, OREGON.