


OK SON
10-20-83

NO ARY PUBLIC
MY COMMISSION EXPIRES 10-

RE: SURVEY No. 8202

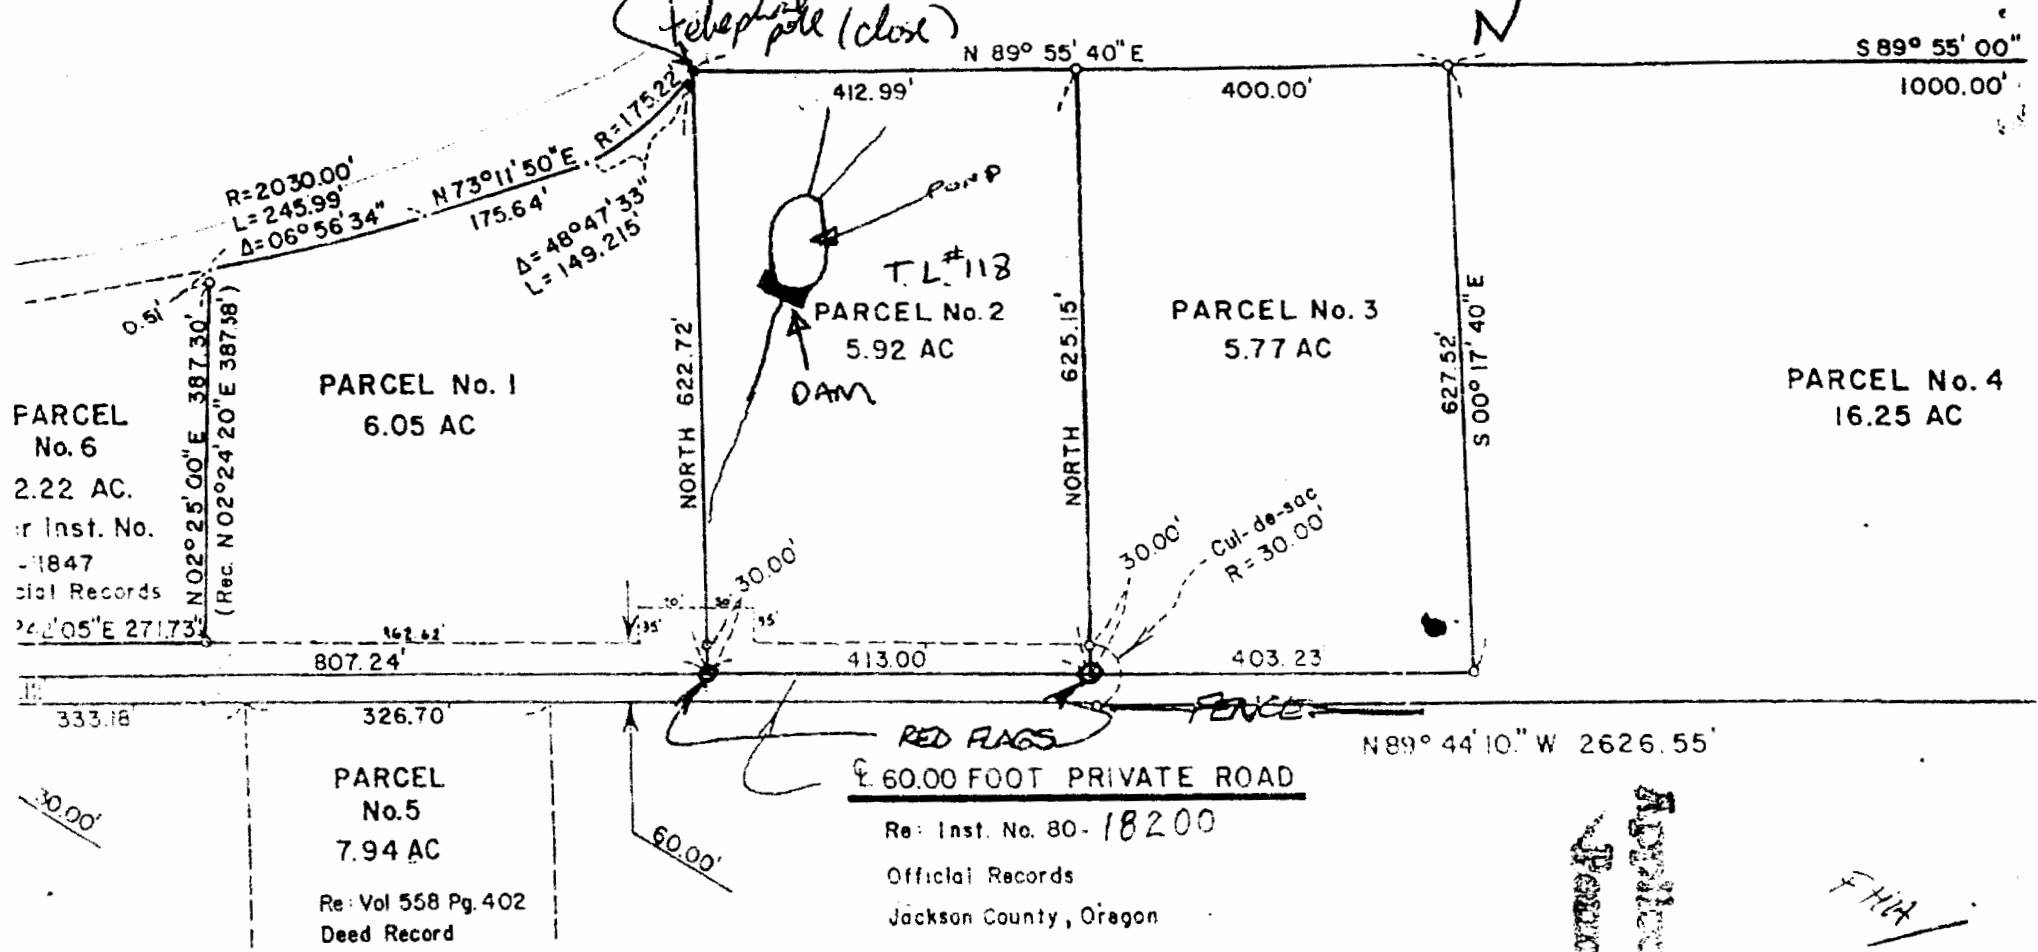

PARCEL No. 6
2.22 AC.
Inst. No.
1847
Official Records
N 02° 25' 00" E 271.73'

PARCEL No. 5
7.94 AC
Re: Vol 558 Pg. 402
Deed Record

RED FLAGS
60.00 FOOT PRIVATE ROAD
Re: Inst. No. 80-18200
Official Records
Jackson County, Oregon</