SECTION 25 T.28S. R.7W. W.M.
DOUGLAS COUNTY

REVISED ON
11-16-94

1"=400'

Application No. R83891
Permit No. R12661

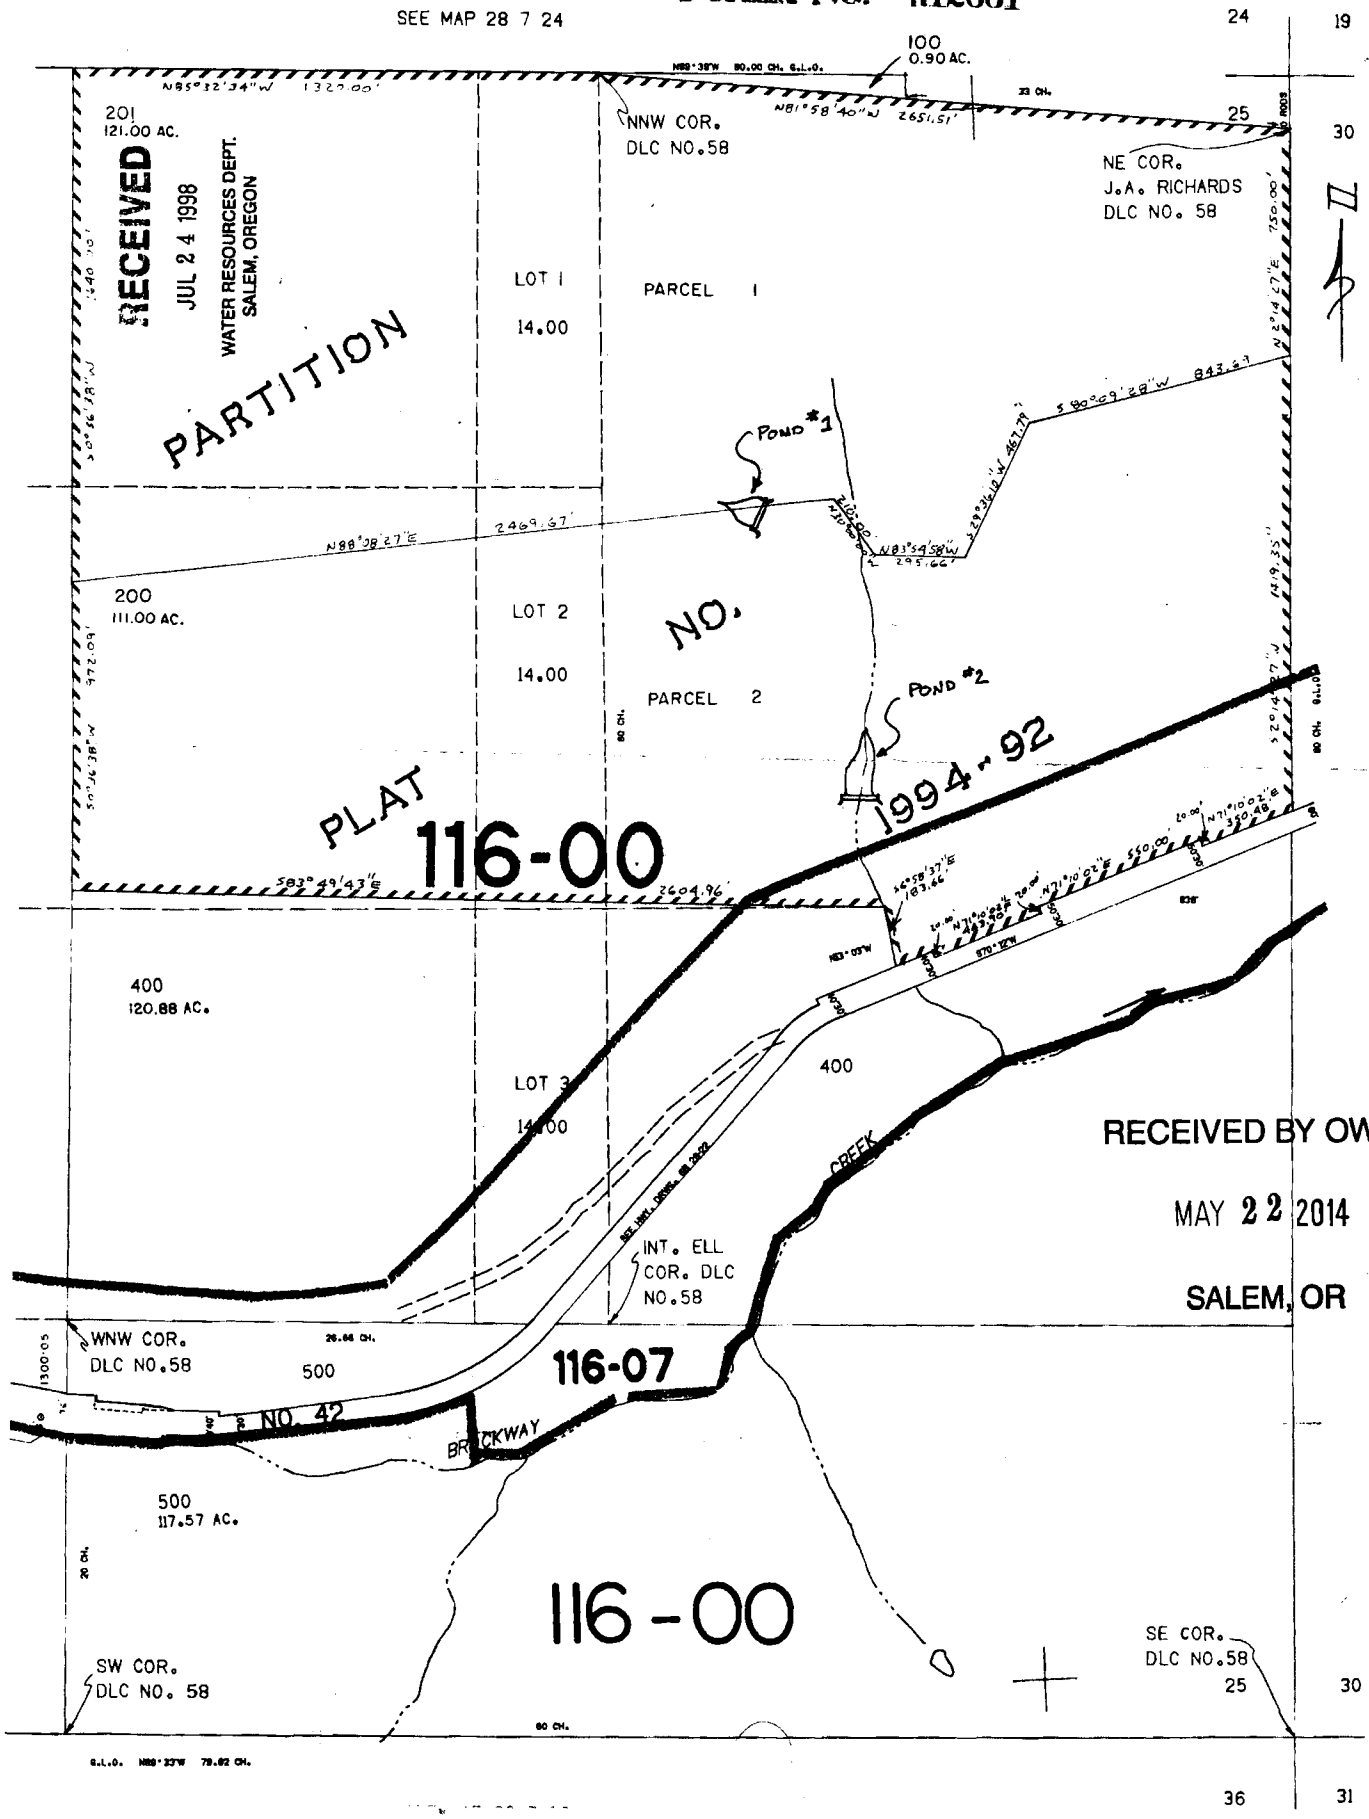

RECEIVED
JUL 24 1998
WATER RESOURCES DEPT.
SALEM, OREGON

RECEIVED BY OWRD
MAY 22 2014
SALEM, OR