


CLAIM OF BENEFICIAL USE MAP

UNDER APPLICATION R-67870; PERMIT R-11709

NE1/4SW1/4 SEC 24 T 28S R 42E W.M.

U.S.G.S. QUAD - BOGUS BENCH, OREG. - 7 1/2'

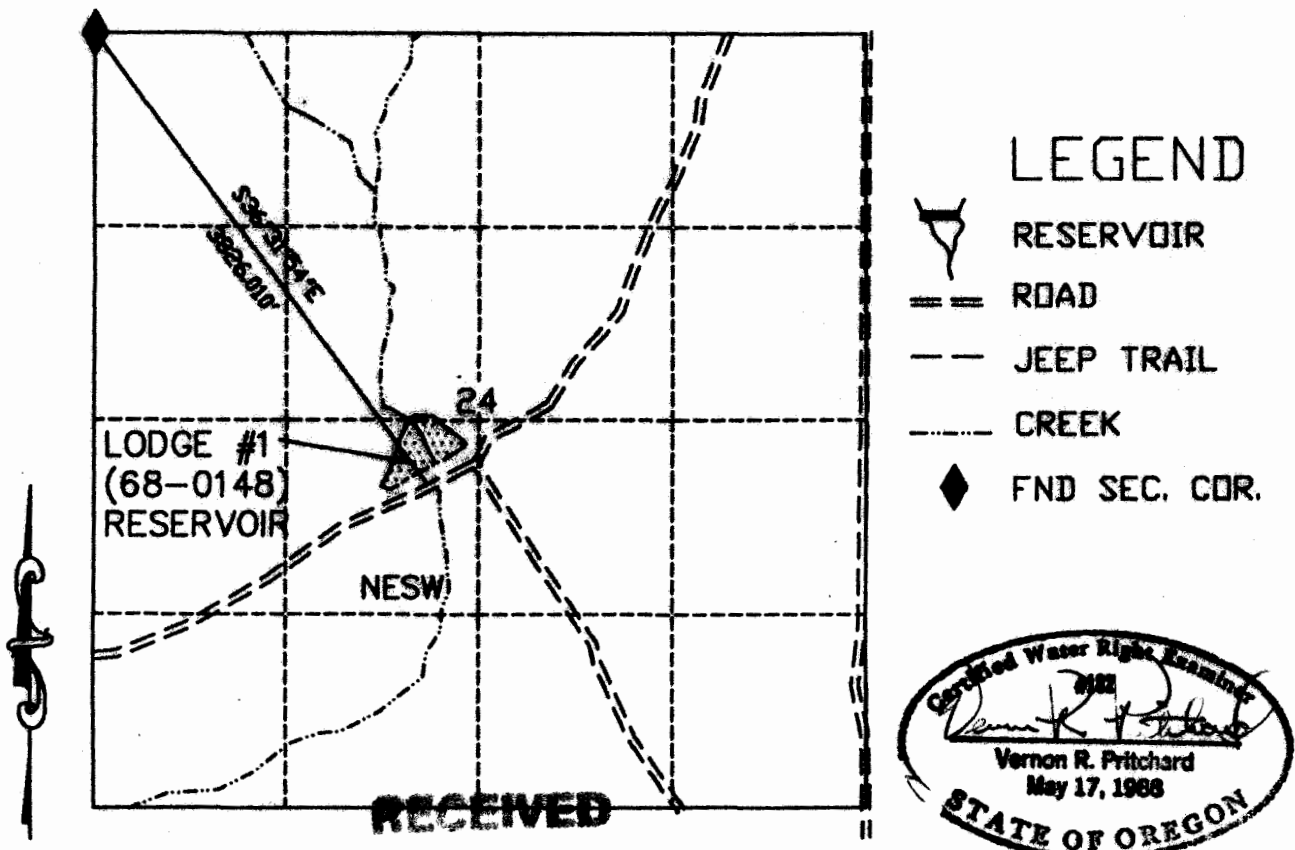

SEP 28 2000
LODGE #1 (68-0148) RESERVOIR
WATER RESOURCES DEPT.
SALEM, OREGON



SCALE 1"=1320'

I, Gayla M. Ernst, Acting ADM Operations/Field Services agree to the findings of the CWRE and do submit this site report and map as my Claim of Beneficial Use of the water as provided under the terms and conditions of my Permit.

Gayla M. Ernst

THIS MAP IS FOR THE PURPOSE OF LOCATING A WATER RIGHT AND IS NOT INTENDED TO PROVIDE LEGAL DIMENSIONS FOR LOCATION OF PROPERTY BOUNDARIES.

ACAD14/SDSK8.0
DWG FILE: LODGE01.DWG

ALWAYS
THINK
SAFETY

UNITED STATES DEPARTMENT OF THE INTERIOR BUREAU OF LAND MANAGEMENT DIVISION OF OPERATIONS VALE DISTRICT	
BENEFICIAL USE MAP LODGE #1 (68-0148) RESERVOIR	
DRAWN BY: <i>Vernon R. Pritchard</i>	
SURVEYED: <i>Vernon R. Pritchard</i>	
APPROVED: <i>Vernon R. Pritchard</i>	
ADM OPERATIONS AND FIELD SERVICES	
DRAWN: CG	SCALE: 1"=1320'
DATE: 08/15/00	SHEET 1 OF 1
DRAWING NO. OR-03-9172.45-1048	