



T6S, R2E, W.M.
SECTION 32
CLACKAMAS COUNTY

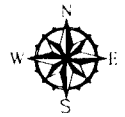

APPLICATION S-85267, PERMIT 53885

CASCADE PACIFIC COUNCIL
OF BOY SCOUTS OF AMERICA

1 INCH = 1320 FEET

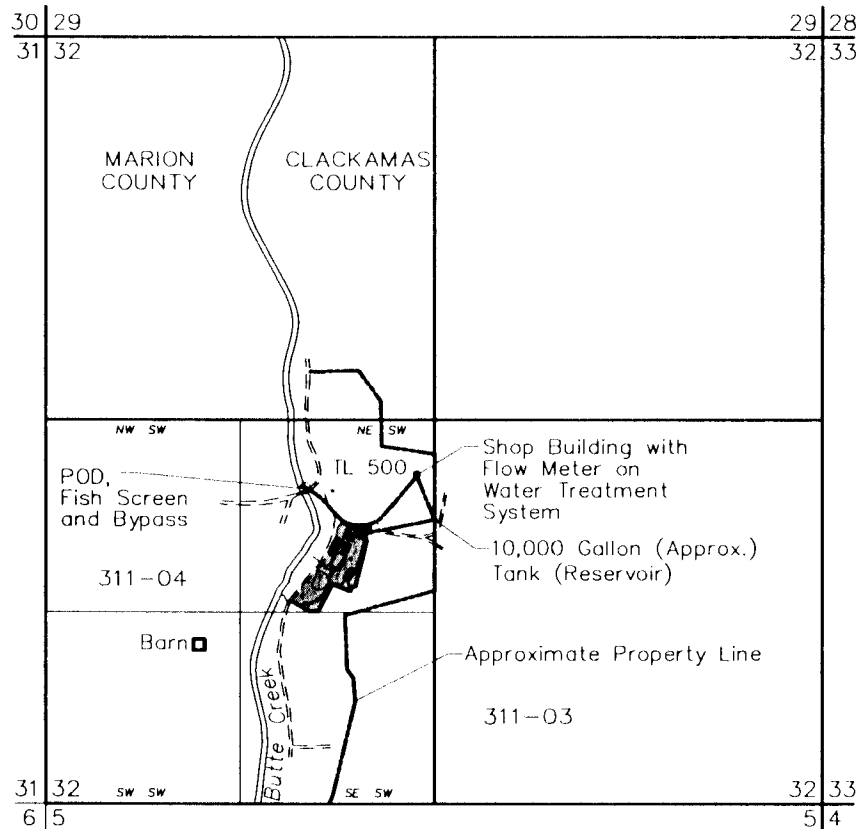

EXPLANATION:



COMMERCIAL USE



1 1/2-INCH-DIAMETER WATER LINE



POINT OF DIVERSION (POD)

NOTES:

1. Point of diversion located 470 feet south and 1,765 feet east of west 1/4 corner of section 32 on east side of creek.
2. Survey completed on 8/10/05.

THIS MAP IS NOT INTENDED TO PROVIDE LEGAL DIMENSIONS OR LOCATIONS OF PROPERTY OWNERSHIP LINES.

Claim of Beneficial Use Map

Cascade Pacific Council of BSA
Clackamas, County

GEOENGINEERS

Figure 1