



EAGLE CREST FINAL PROOF SURVEY

PREPARED 09/14/93

T. 15 S, R12 E W.M.
DESCHUTES COUNTY

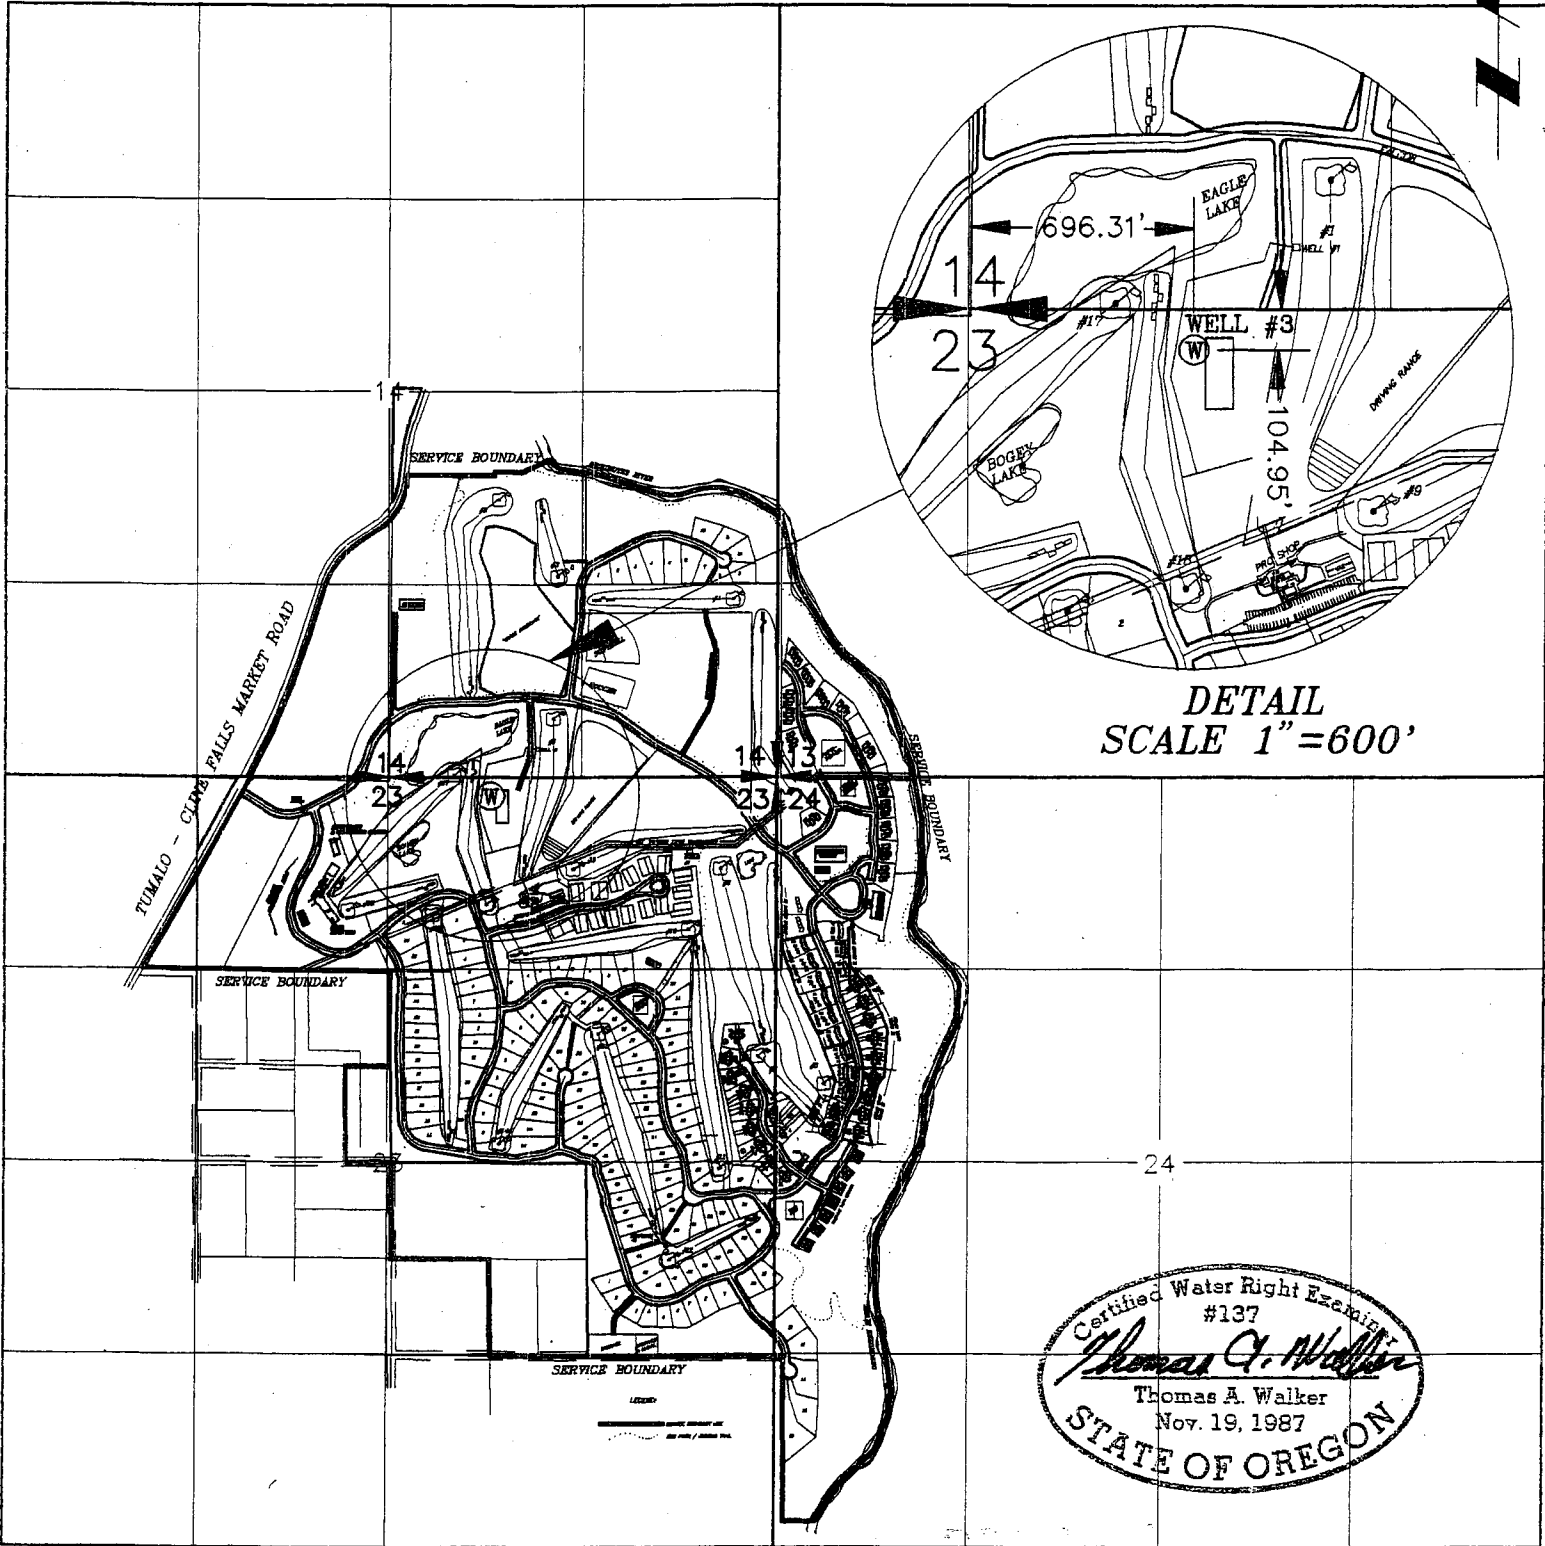

DETAIL
SCALE 1" = 600'

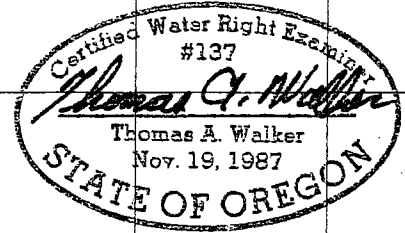

APPLICATION NO. G-11824 PERMIT NO. G-10957

SCALE: 1" = 1320'

LEGEND

⊙ WELL LOCATION

W&H PACIFIC
155 N.E. REVERE
BEND, OREGON 97701
(503) 388-4255
ENGINEERING • PLANNING • SURVEYING • LANDSCAPE ARCHITECTURE

BASE MAP
PREPARED BY: HICKMAN, WILLIAMS & ASSOCIATES, INC.
20360 EMPIRE ROAD, SUITE C-4
BEND, OREGON 97701