


MAP

Accompanying Final Proof of Permit No 11388 Appl. No 11388 in the name of
 H.F. Swingle of Ashland Oregon to the waters of unnamed Gulch
 tributary to Bear Creek Jackson County Oregon for Irrigation use.

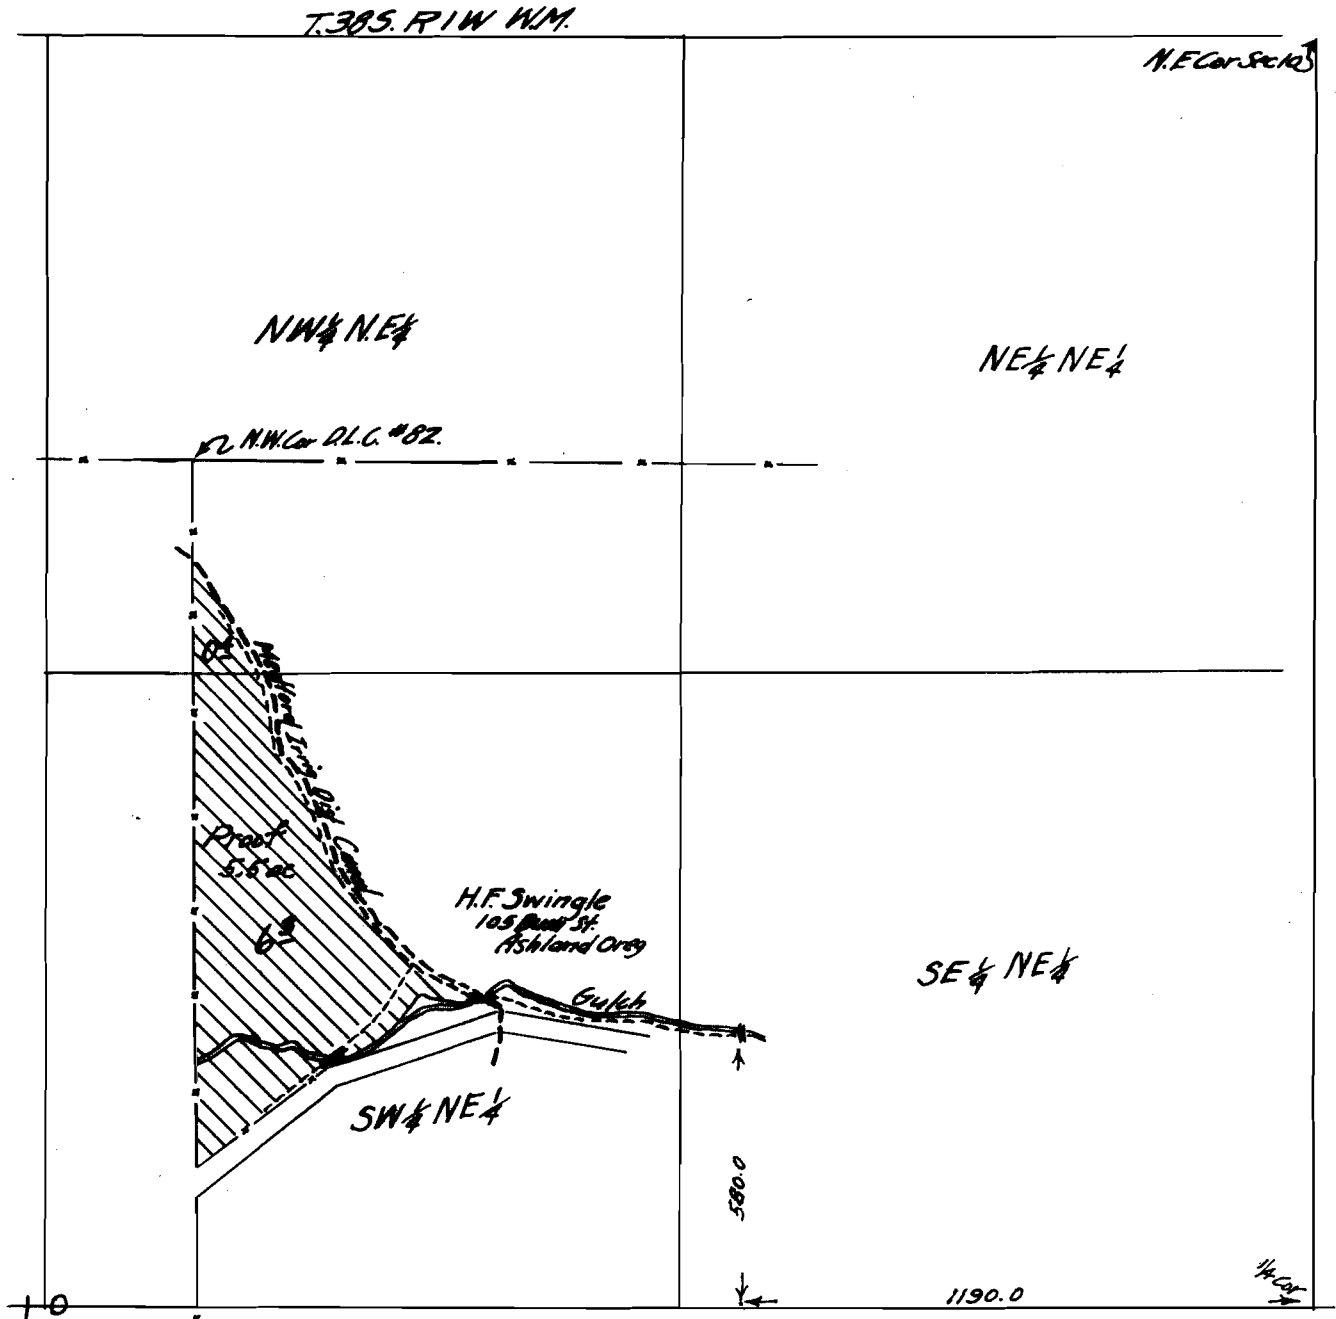

Map made from Plane Table survey by Chester A. Cummings

11388