

FINAL PROOF SURVEY MAP MT. JEFFERSON FARMS INC. Application G-14389 Permit G-13221

T 9 S R 3 W, W.M. Section 2 & 11

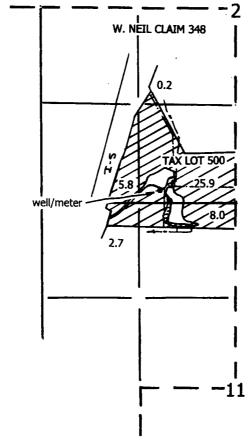

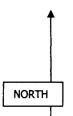

Well/Meter: 160' N & 1025' W from the S 1/4 corner Section 2

Scale 4'' = 1 mile

This map is not intended to provide legal dimensions or locations of property ownership lines.

DONALD E. RNAUER
STATE OF OREGON

ENEWAL DATE: 6-30 3013