

RECEIVED


MAY - 7 1997

WATER RESOURCES DEPT.
SALEM, OREGON

Application No. 68587

Permit No. 51126

CP - covers
1000 GPM
low pressure

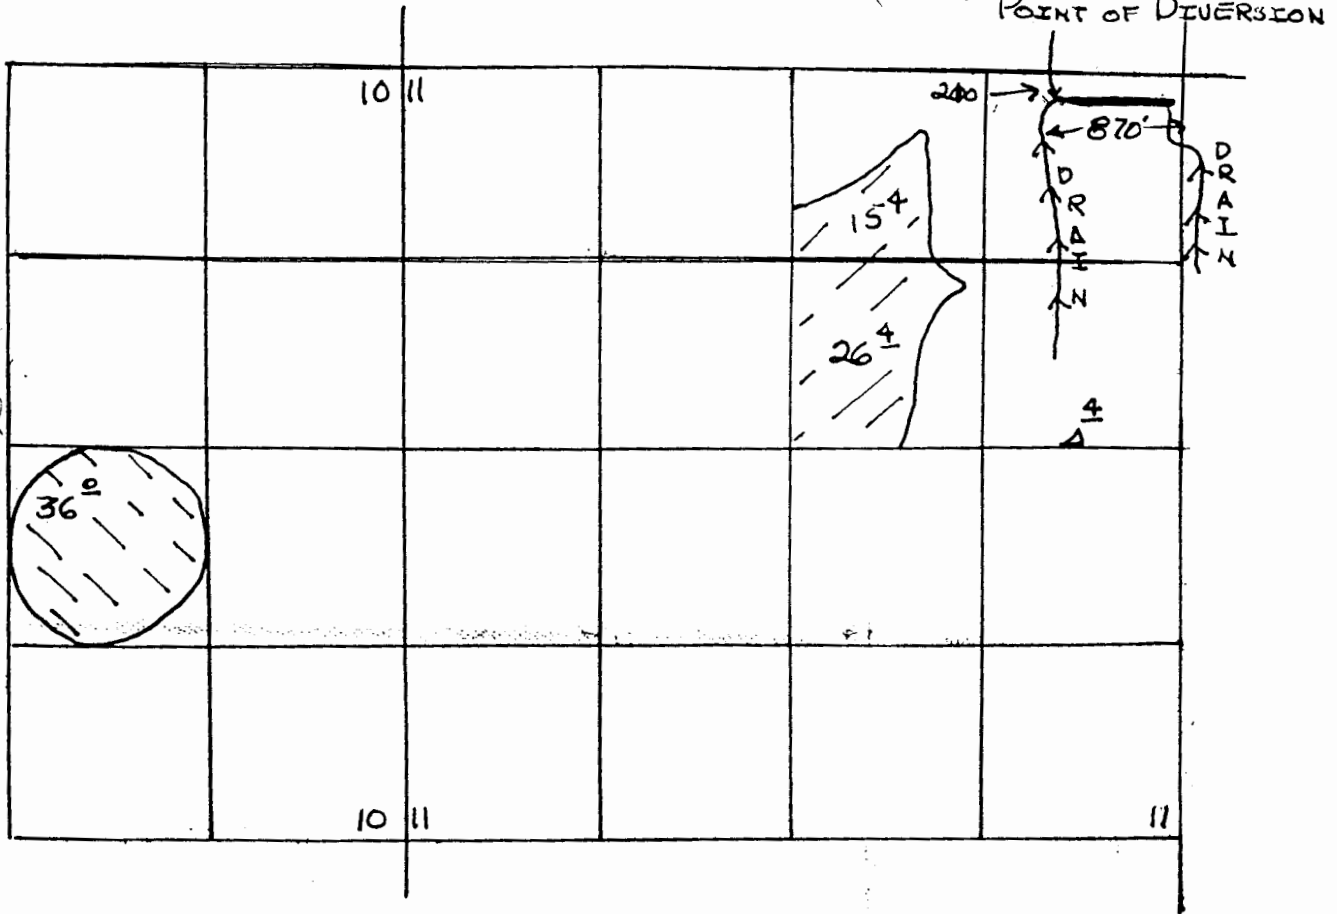

Best motor
CDM
50 HP

30 HP
10' above
drain
from closed p.t. wells

T. 3 N. R. 28 E.

Supplemental
~~Primary~~ \ \ \ \

Supplemental \ \ \ \

All areas to receive a supplemental
supply from unnamed drain

RECEIVED

JAN 06 1986

WATER RESOURCES DEPT.
SALEM, OREGON

REVISED MAP

SURFACE WATER

RECEIVED
JAN 06 1986
WATER RESOURCES DEPT.
SALEM, OREGON