


SALEM, OR

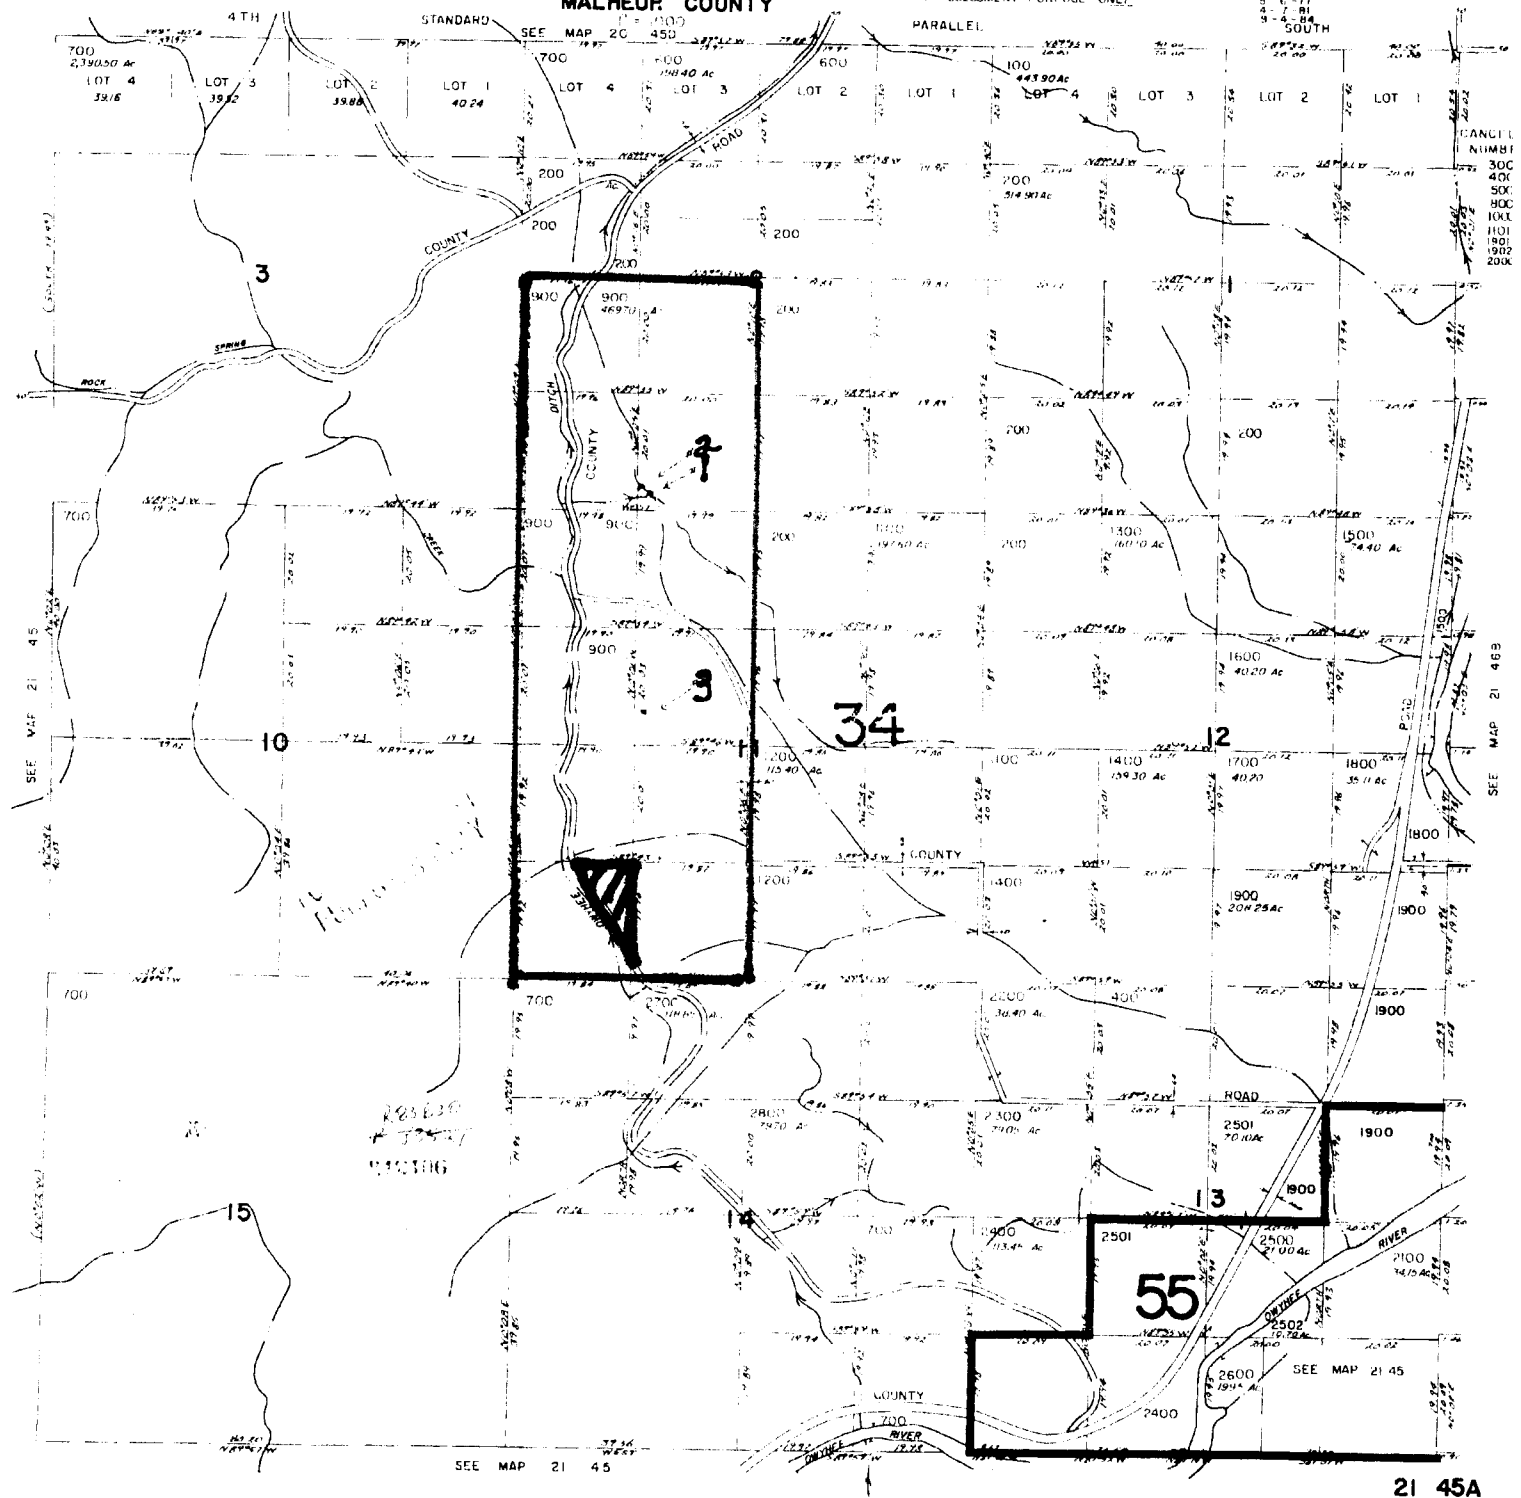

21 45A