RECEIVED
APR 5 1999
WATER RESOURCES DEPT.
SALEM, OREGON

RECEIVED
MAY 18 1999
WATER RESOURCES DEPT.
SALEM, OREGON

RECEIVED BY OWRD
JAN 12 2015
SALEM, OR

Application No R-84143
Permit No. R-12773

SW1/4 SEC. 25 T. 26S. R. 7W. W.M.
DOUGLAS COUNTY

1" = 200'

REVISED ON
1-8-1996

26 7 25C

CANCELLED NO'S
201 206 208
1201
500MI
1101

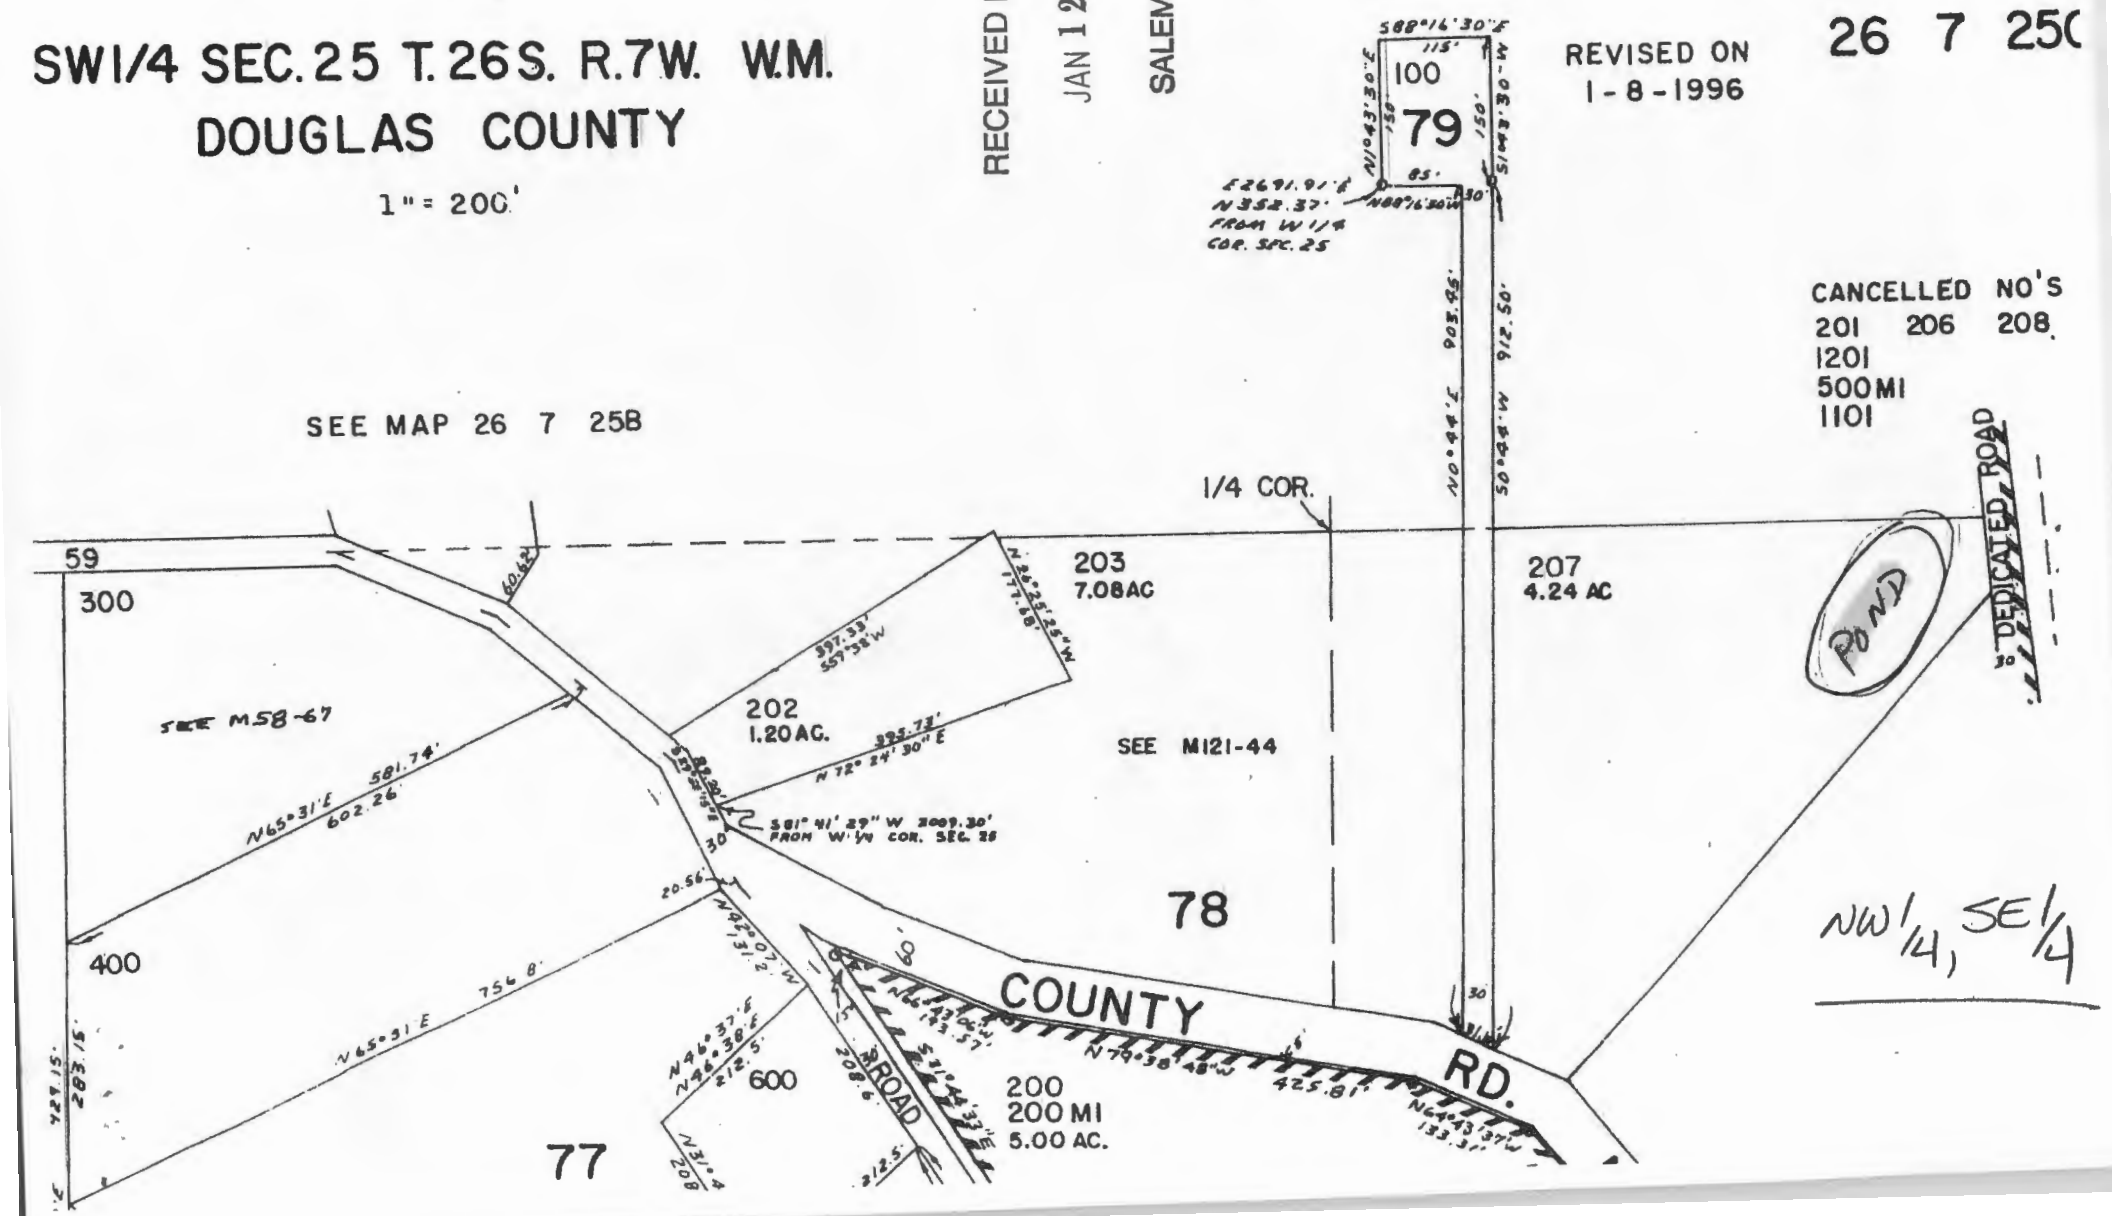

NW1/4, SE1/4