

# FINAL PROOF SURVEY

SITUATED IN THE E1/2 OF THE NE1/4  
OF SECTION 34, T34S, R8EWM,  
KLAMATH COUNTY, OREGON  
DECEMBER, 2004

RECEIVED


DEC 29 2004

WATER RESOURCES DEPT  
SALEM, OREGON

MAP PREPARED FROM  
AERIAL PHOTOGRAPH

PERMIT #G-12638

APPLICATION #G-13858

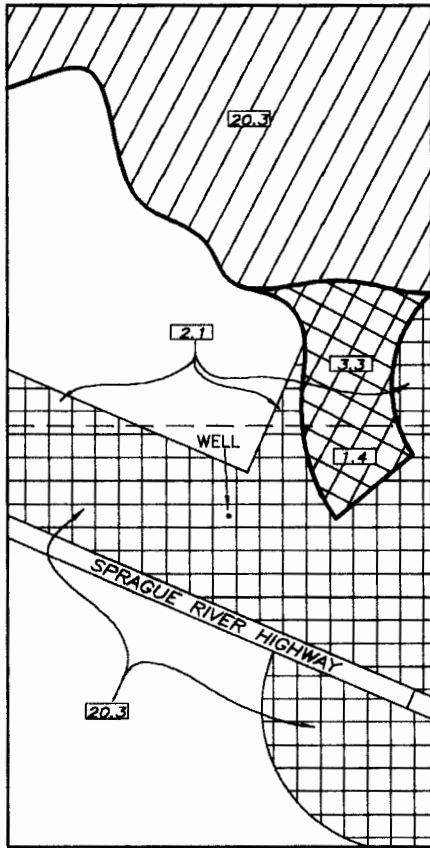

SCALE  
1' = 600'

TOTAL AREA  
--47.4 ACRES--

E  
NE1/4  
34|35

MAP PREPARED FOR  
--DAVID ROGERS--

LOCATION OF WELL BY FIELD INSPECTION

N72°37'00"W 3433 FEET <sup>FROM</sup> TO THE CENTER  
QUARTER CORNER OF SECTION 35




PRIMARY LANDS THIS SURVEY  
SPRINKLER IRRIGATED 22.4 Ac.



PRIMARY LANDS THIS SURVEY  
FLOOD IRRIGATED 4.7 Ac.



LANDS SUPPLEMENTAL TO THE  
WATER RIGHT CERTIFICATE RECORDED  
IN VOLUME 25, PAGE 33,614 20.3 Ac.

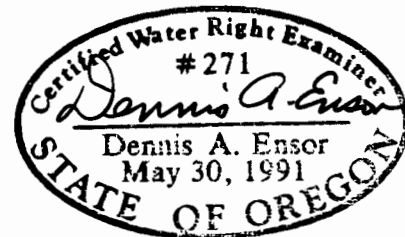

EXPIRES: 12/31/05

TRU-LINE SURVEYING, INC.  
2333 SUMMERS LANE  
KLAMATH FALLS, OREGON 97603

THE PURPOSE OF THIS MAP IS TO IDENTIFY  
THE LOCATION OF THE WATER RIGHT. IT IS NOT  
INTENDED TO PROVIDE INFORMATION RELATIVE TO  
THE LOCATION OF PROPERTY OWNERSHIP BOUNDARY  
LINES.

Map Updated 5/13/15 DC/WRD