
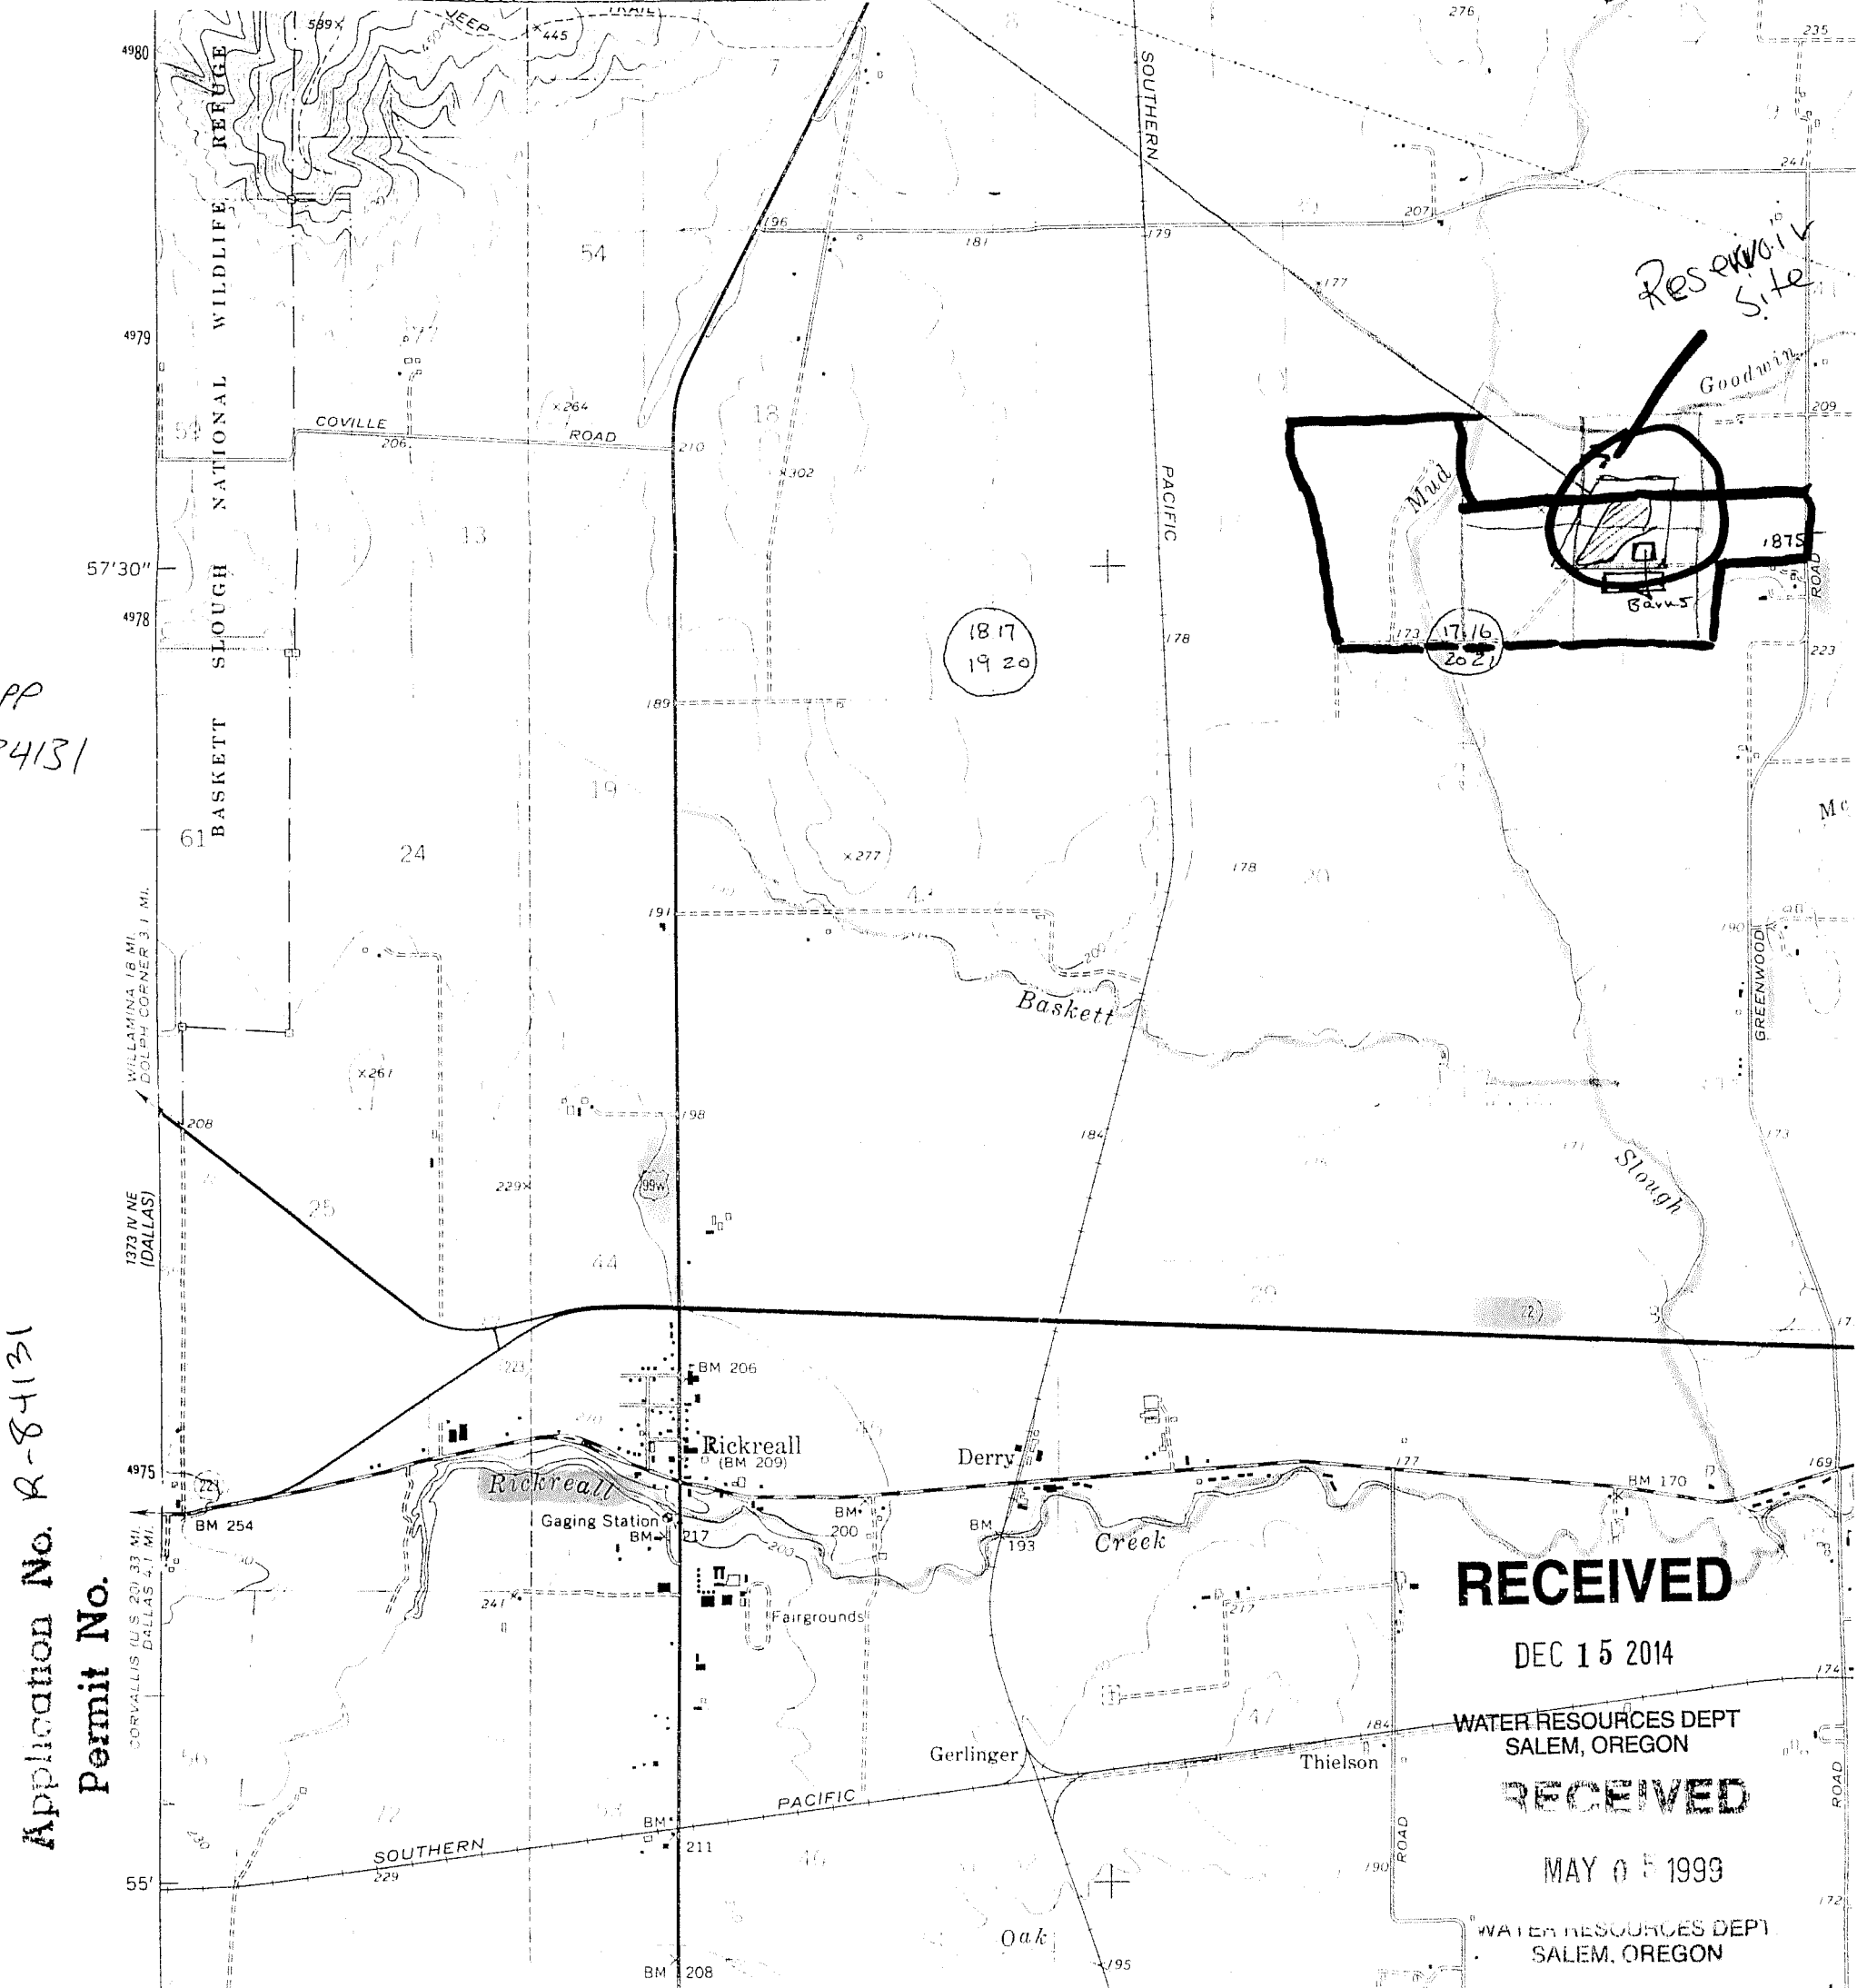
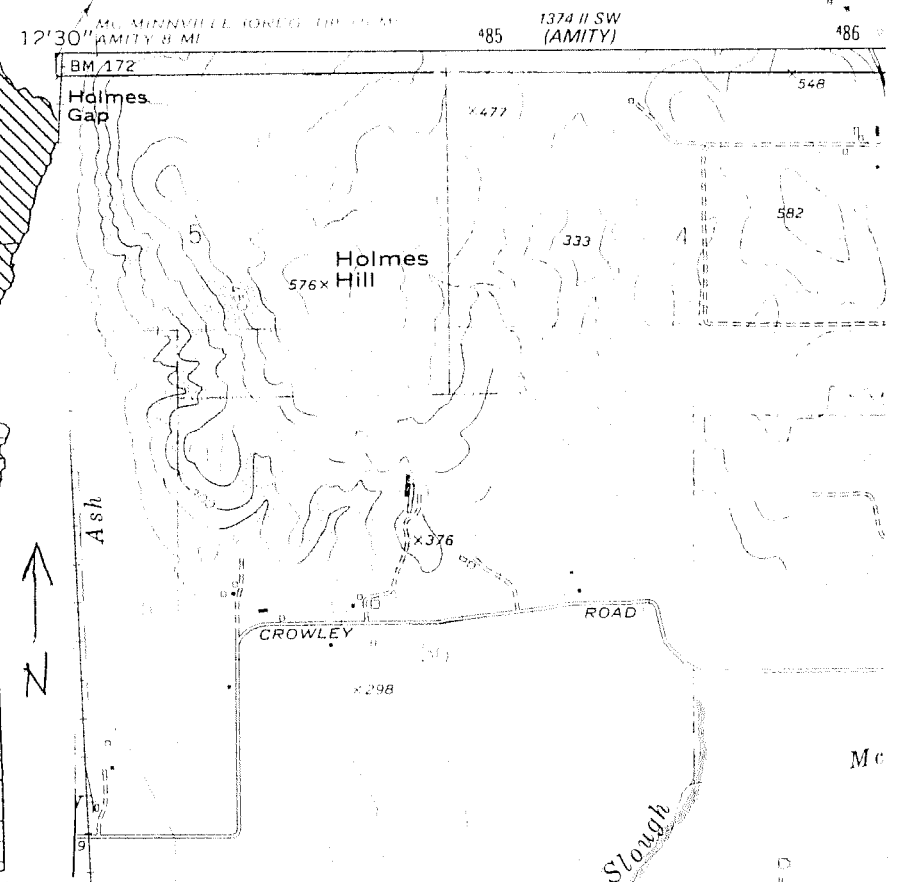


UNITED STATES
DEPARTMENT OF THE INTERIOR
GEOLOGICAL SURVEY

T15 R4W

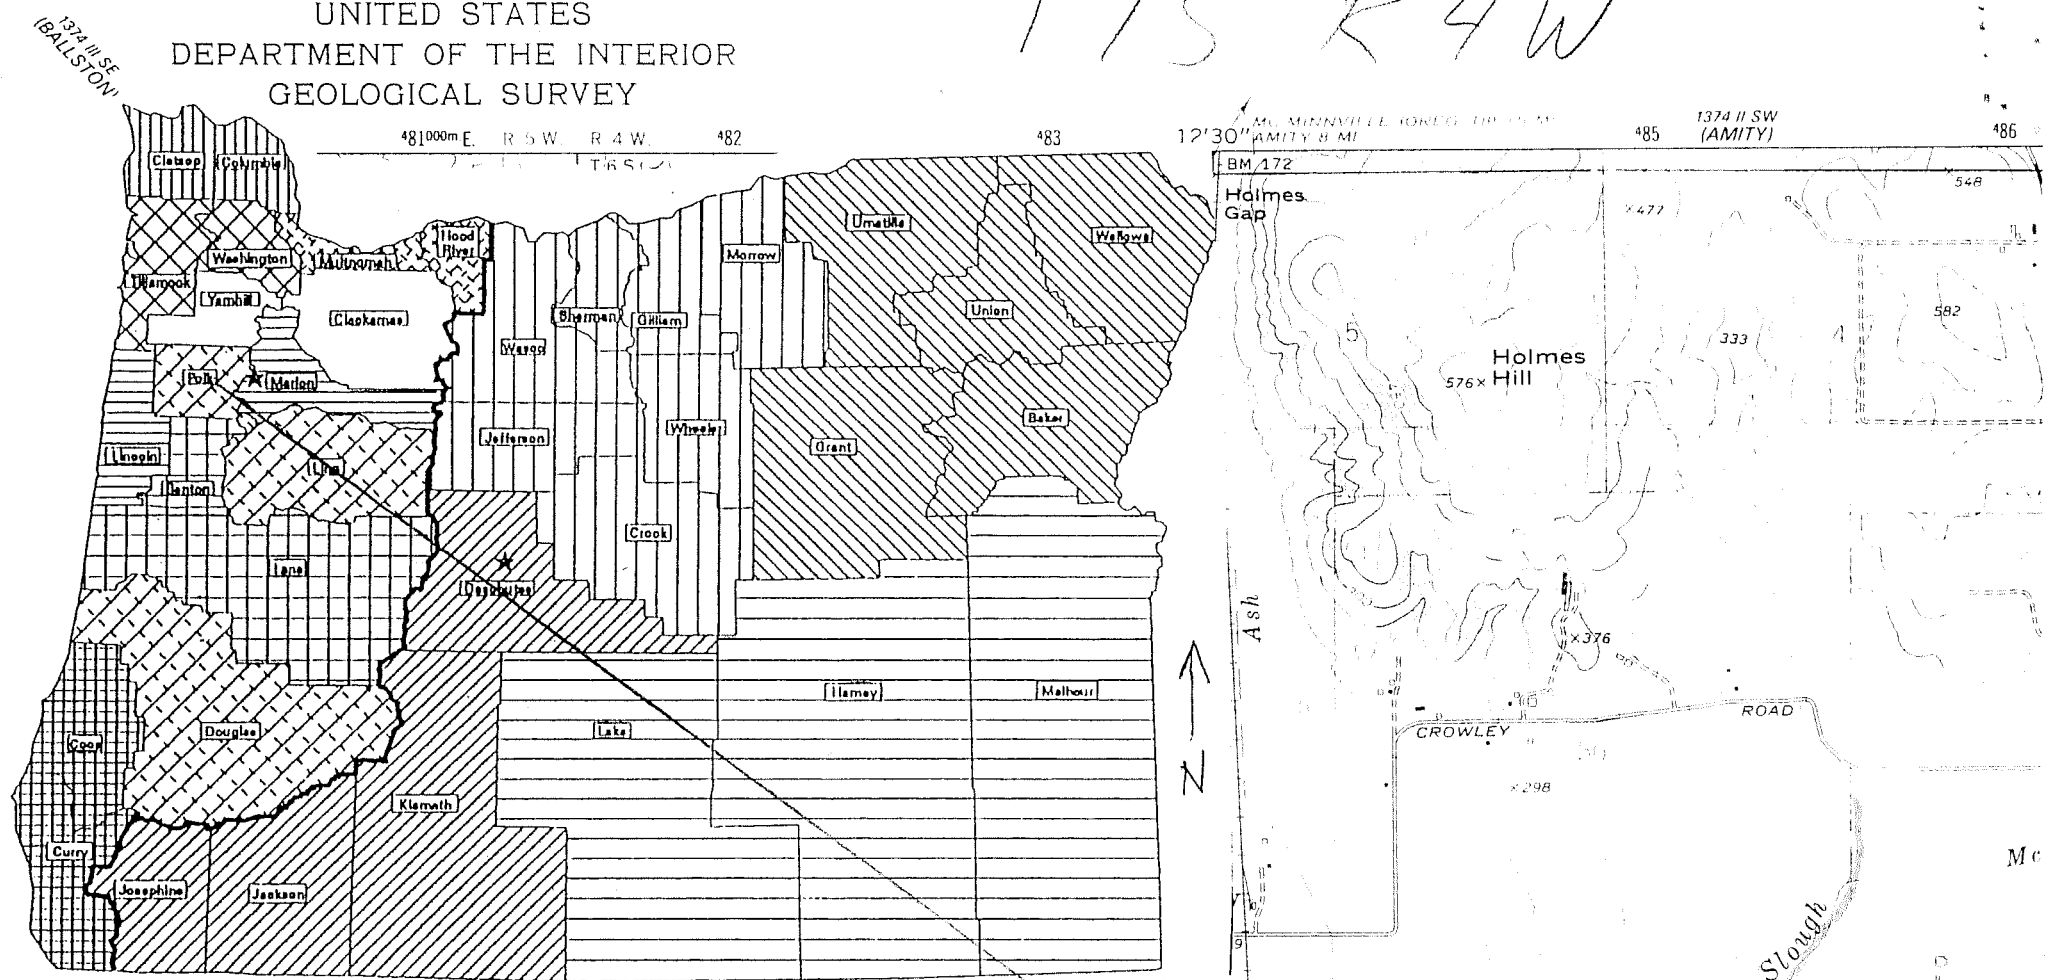

199
84131

Application No. R-84131
Permit No.

RECEIVED

DEC 15 2014

WATER RESOURCES DEPT
SALEM, OREGON

RECEIVED

MAY 05 1999

WATER RESOURCES DEPT
SALEM, OREGON