

CLAIM OF BENEFICIAL USE MAP


T11S, R1W, W.M., SECTION 31

APPLICATION NO.: R-81759

PERMIT NO.: R-12760

DAM LOCATION: NE1/4 SE1/4, SECTION 31, 1,740 FEET NORTH 320' EAST
FROM THE E1/16 CORNER ON THE SOUTH LINE SECTION 31.

SUBMERGED AREA: NE1/4 SE1/4, SECTION 31, T11S, R1W, W.M.

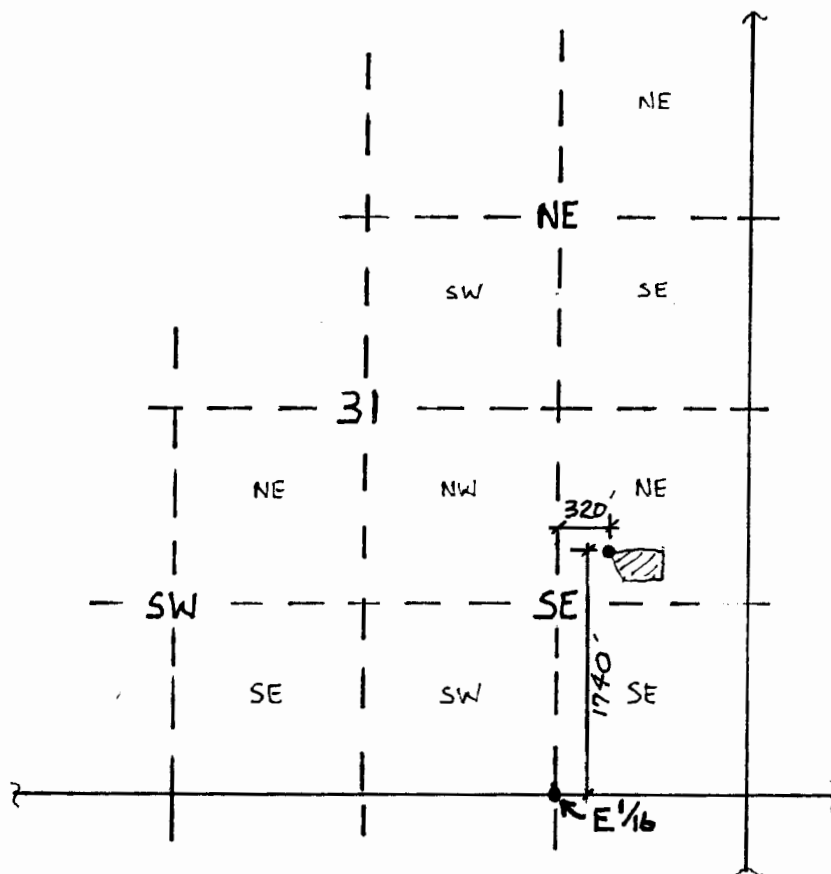

SCALE: 1"=1,320 FEET

OWNER: ALTON SULLIVAN AND JOHN DORAN

update { P.O. BOX 2690
ALBANY, OR 97321

RECEIVED BY OWNER

FEB 02 2015

SALEM, OR