

CLAIM OF BENEFICIAL USE MAP


T11S, R1W, W.M., SECTION 31

APPLICATION NO.: R-81760

PERMIT NO.: R-12761

DAM LOCATION: SE 1/4 NE 1/4, SECTION 31, 2940 FEET NORTH 75' EAST
FROM THE E 1/16 CORNER ON THE SOUTH LINE SECTION 31.

SUBMERGED AREA: SE 1/4 NE 1/4, SECTION 31, T11S, R1W, W.M. E
NE 1/4 SE 1/4 SECTION 31, T11S, R1W, W.M.

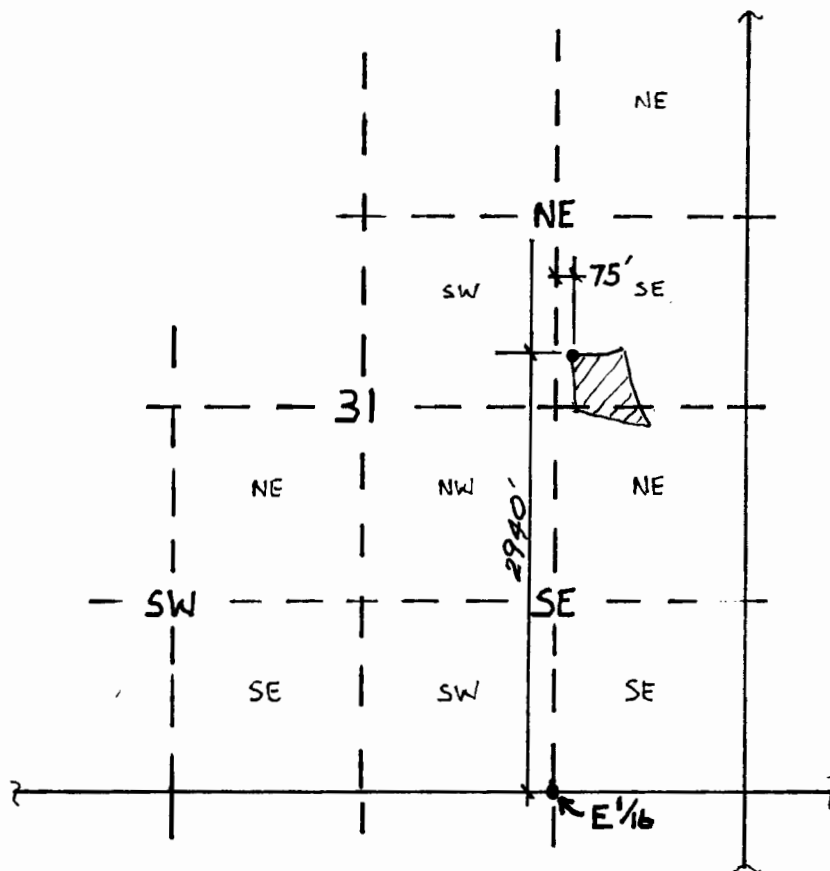

RECEIVED BY OWRD

FEB 02 2015

SALEM, OR

SCALE: 1"=1,320 FEET

OWNER: ALTON SULLIVAN AND JOHN DORAN
P.O. BOX 2690
ALBANY, OR 97321


