


T. 17 & 18 S., R. 25 E., W.M.

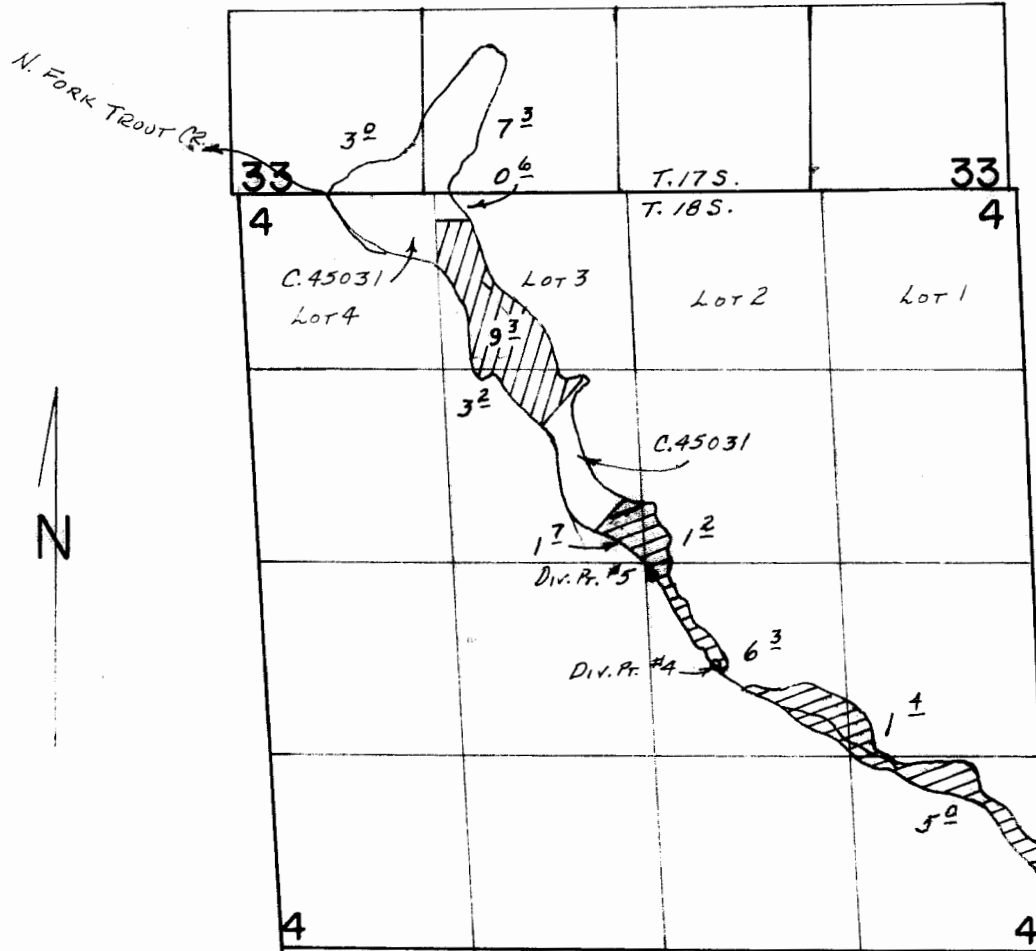


DIV. PTS. LOC.: #4- 700'S. & 480'E., #5- 80'S. & 50'E.,
BOTH FROM CENTER OF SECTION 4.

SCALE: 1"=1320'

FINAL PROOF SURVEY

UNDER

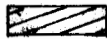Transfer No. 3671 
Application No. 55890 Permit No. 42026 
IN NAME OF

MELVIN WEBERG & CO.

Surveyed NOV 2, 1992, by R.M. SUTTERFIELD