


SECTION 1, TOWNSHIP 1 N. RANGE 9 E. W.M.
 HOOD RIVER COUNTY, OREGON

RECEIVED

OCT 01 1999

WATER RESOURCES DEPT.
 SALEM, OREGON

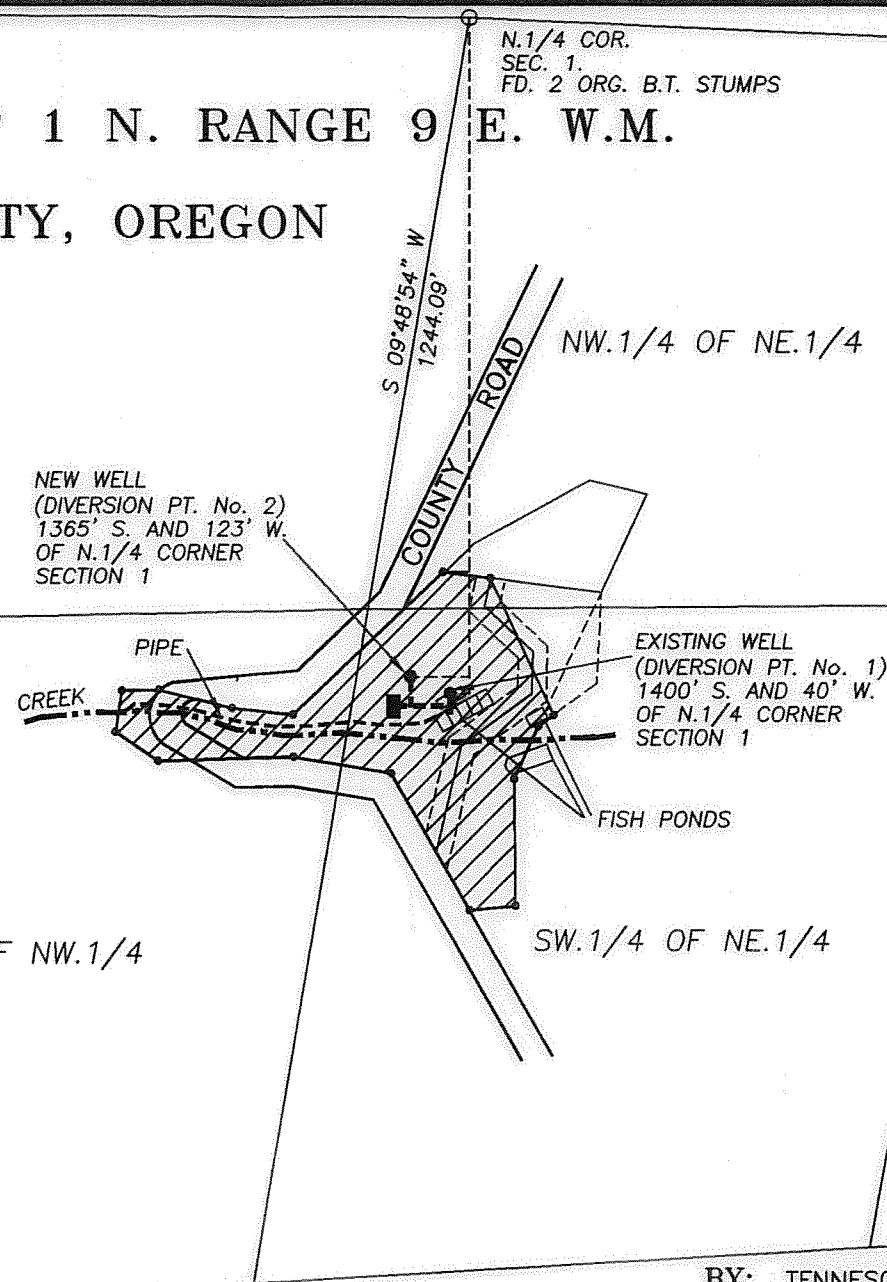

WATER RIGHT
 FINAL PROOF SURVEY

SCALE: 1" = 400'

CERTIFICATE No. 55582

PERMIT No. G-8110 T-7847

IN THE NAME OF:

EDWARD MCLEARY

DATE: SEPTEMBER 22, 1999

BY: TENNESON ENGINEERING CORP.
 409 LINCOLN STREET,
 THE DALLES, OREGON. 97058
 PH. 541-296-9177
 FAX 541-296-6657

NOTE:

"THIS MAP IDENTIFIES THE LOCATION OF
 THE WATER RIGHT ONLY AND IS NOT
 INTENDED TO PROVIDE DIMENSIONS OR
 LOCATE PROPERTY OWNERSHIP LINES."



W.O. #8882