


RECEIVED

FEB 10 2005

WATER RESOURCES DEPT
SALEM, OREGON

T 25 S, R 34 E, WM

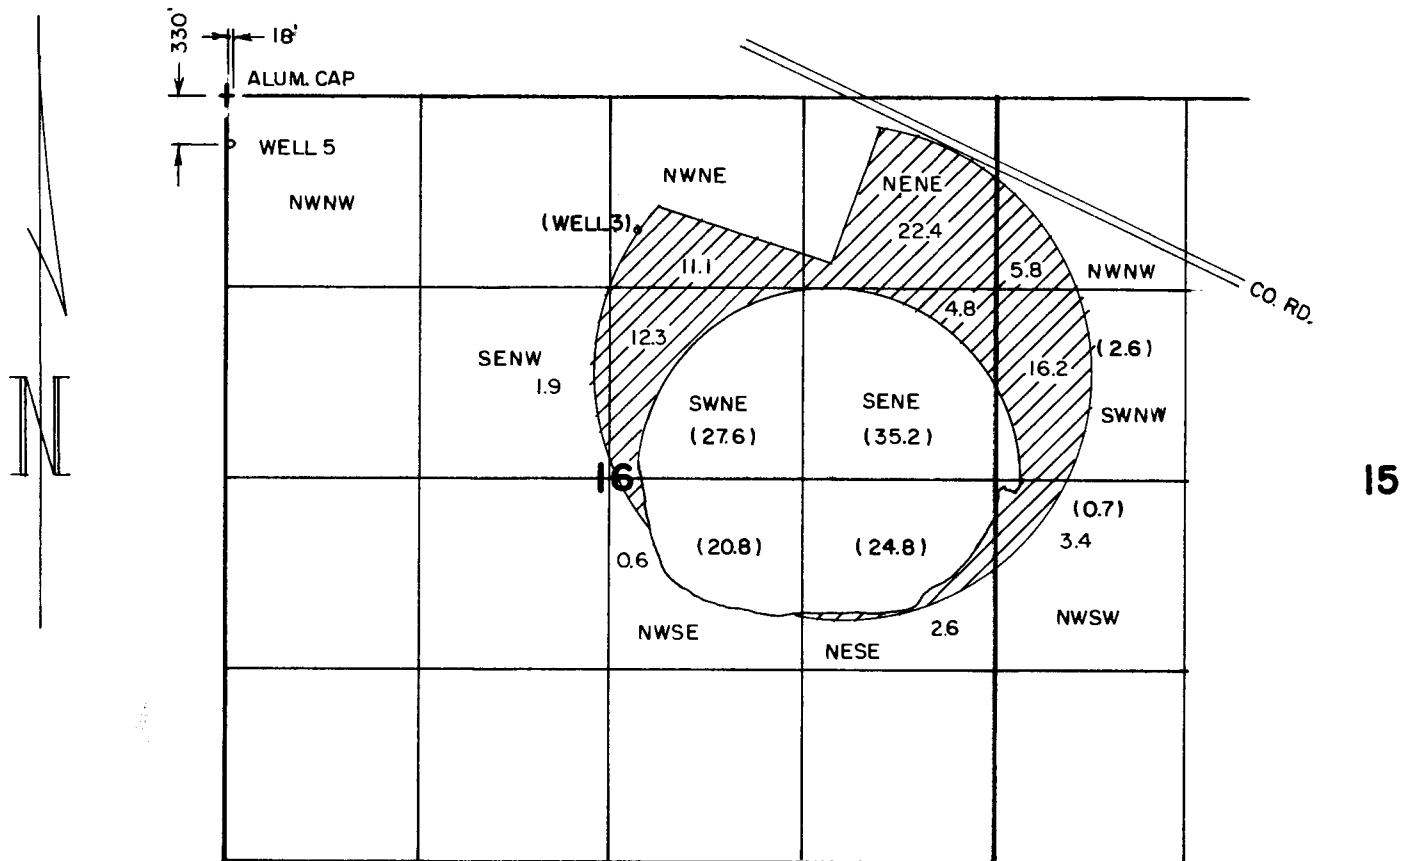

THE PURPOSE OF THIS MAP IS TO
IDENTIFY THE LOCATION OF THE
WATER RIGHT. IT IS NOT INTENDED
TO PROVIDE INFORMATION RELATIVE
TO THE LOCATION OF PROPERTY
OWNERSHIP.

- IRRIGATED LAND & THE WELL ARE WITHIN TAX LOT 900, T25S, R34E, WM -

LEGEND

() DATA RECORD - FINAL PROOF SURVEY MAP BY V.L. CHURCH DATE 5-9-1988
UNDER PERMIT G-9814.

FINAL PROOF SURVEY

UNDER
APPLICATION G-14720
PERMIT G-13563

IN THE NAME OF
DON CODY

Scale: 4" = 1 MILE

Date: OCT 2004

Job: 1715

Dsn:

Drn: CHRIS

Ckd:

MAP's

M. A. PALMER & SONS, INC.
ENGINEERING & SURVEYING
254 N. Alder - Box 61
Burns, Oregon 97720

Sht. No.

of 1

