
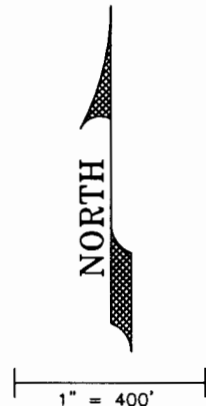


# CLAIM OF BENEFICIAL USE MAP IN THE NAME OF DUANE BROWN AND BILL ZERBACH

APPLICATION S-85432      PERMIT S-54244


TOWNSHIPS 26 SOUTH, RANGE 3 WEST, W.M., SECTION 9, SE1/4 SW1/4

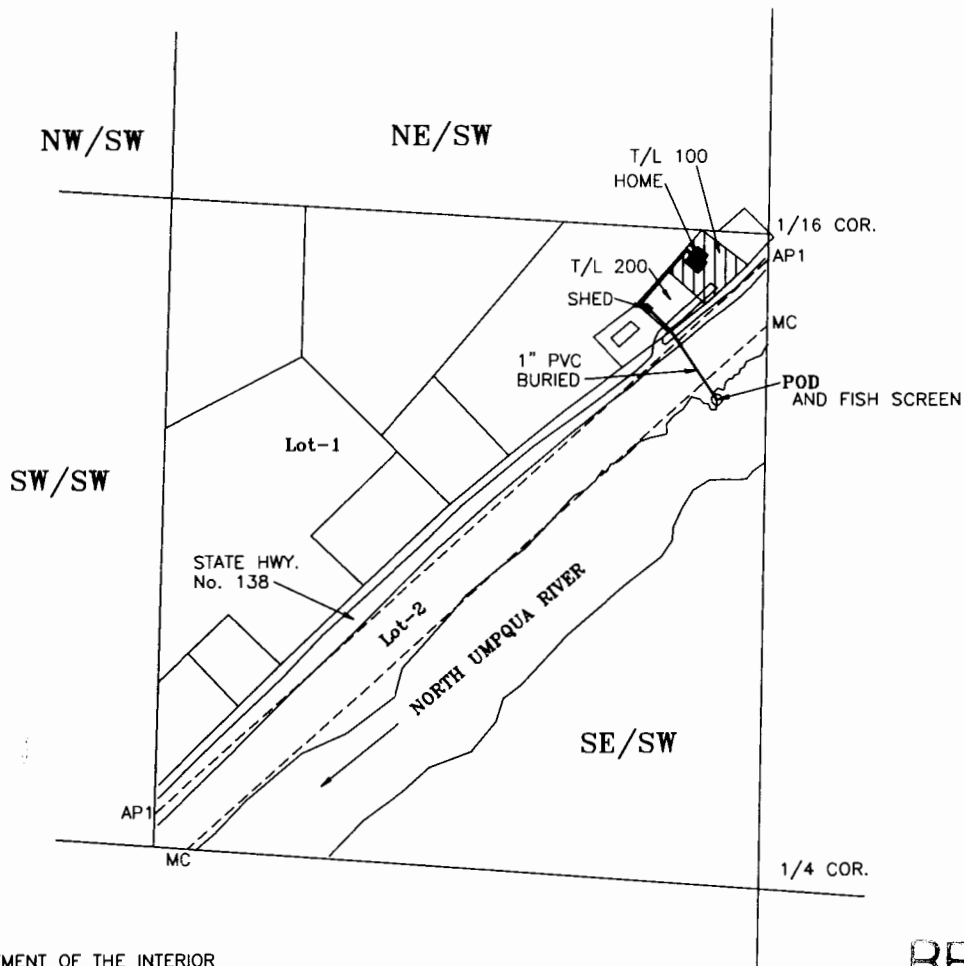

PER DEPARTMENT OF THE INTERIOR  
GENERAL LAND OFFICE 8-9-1926  
SURVEY 1-28-1926

AP1 & 2 = BLM'S ANGLE POINT  
MC = BLM'S MEANDERING CORNER  
----- GOVERNMENT LOT LINE

POD COORDINATES:  
SW1/4 SW1/4 S9, T26S, R3W  
1020 FEET NORTH AND 85 FEET  
WEST FROM S1/4 CORNER.

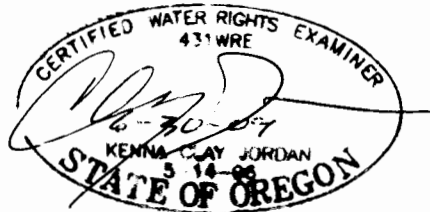

LOCATIONS PER 1/4 1/4 ARE DERIVED BY ASSUMED FIT  
OF AERIAL PHOTO ORIENTATION TO GROUND SURVEYS  
AND/OR TAX ASSESSOR MAPS.

THE PURPOSE OF THIS MAP IS TO IDENTIFY THE LOCATION OF THE WATER RIGHT.  
IT IS NOT INTENDED TO PROVIDE INFORMATION RELATIVE TO THE LOCATION OF  
PROPERTY OWNERSHIP BOUNDARY LINES.

**JORDAN ENGINEERING**  
460 JORDAN LANE  
ROSEBURG, OR 97470  
(541) 673-1931

6-12-08