

CLAIM OF BENEFICIAL USE - FINAL PROOF SURVEY MAP
FOR APPLICATION NUMBER: S-86070 PERMIT NUMBER: 54157
COOS BAY YACHT CLUB NE1/4 NW1/4 S21 T23S, R12W, WM. LOT 100

FISH SCREEN AT
 POINT OF DIVERSION
 250.7 FT N. & 820.3 FT W.
 FROM NE1/4 NW1/4 OF
 SECTION 21

SE CORNER,

SCHOOL LAND BAY

METER AT
 PLACE OF USE
 180' FROM POD

RECEIVED

MAY 23 2006

WATER RESOURCES DEPT.
 SALEM, OREGON

SOUTH TENMILE LAKE


3/4" PIPE
 LOCATION,
 BURIED

CBYC PROPERTY

CBYC PROPERTY

CBYC PROPERTY

CBYC PROPERTY

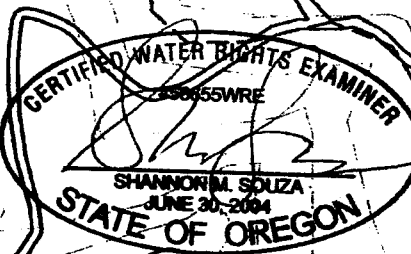

EXPIRATION DATE: 6/30/08



THE PURPOSE OF THIS MAP IS TO IDENTIFY THE LOCATION OF THE WATER RIGHT.
 IT IS NOT INTENDED TO PROVIDE INFORMATION RELATIVE TO THE LOCATION OF
 PROPERTY OWNERSHIP BOUNDARY LINES

COOS BAY YACHT CLUB

SCALE: 1" = 400'

*This map has been revised by WRD to reflect the measured distance
 reference corner, as being the SE CORNER, NENW. MB/WRD 7-31-15*