



T 21 S, R 20 E, WM

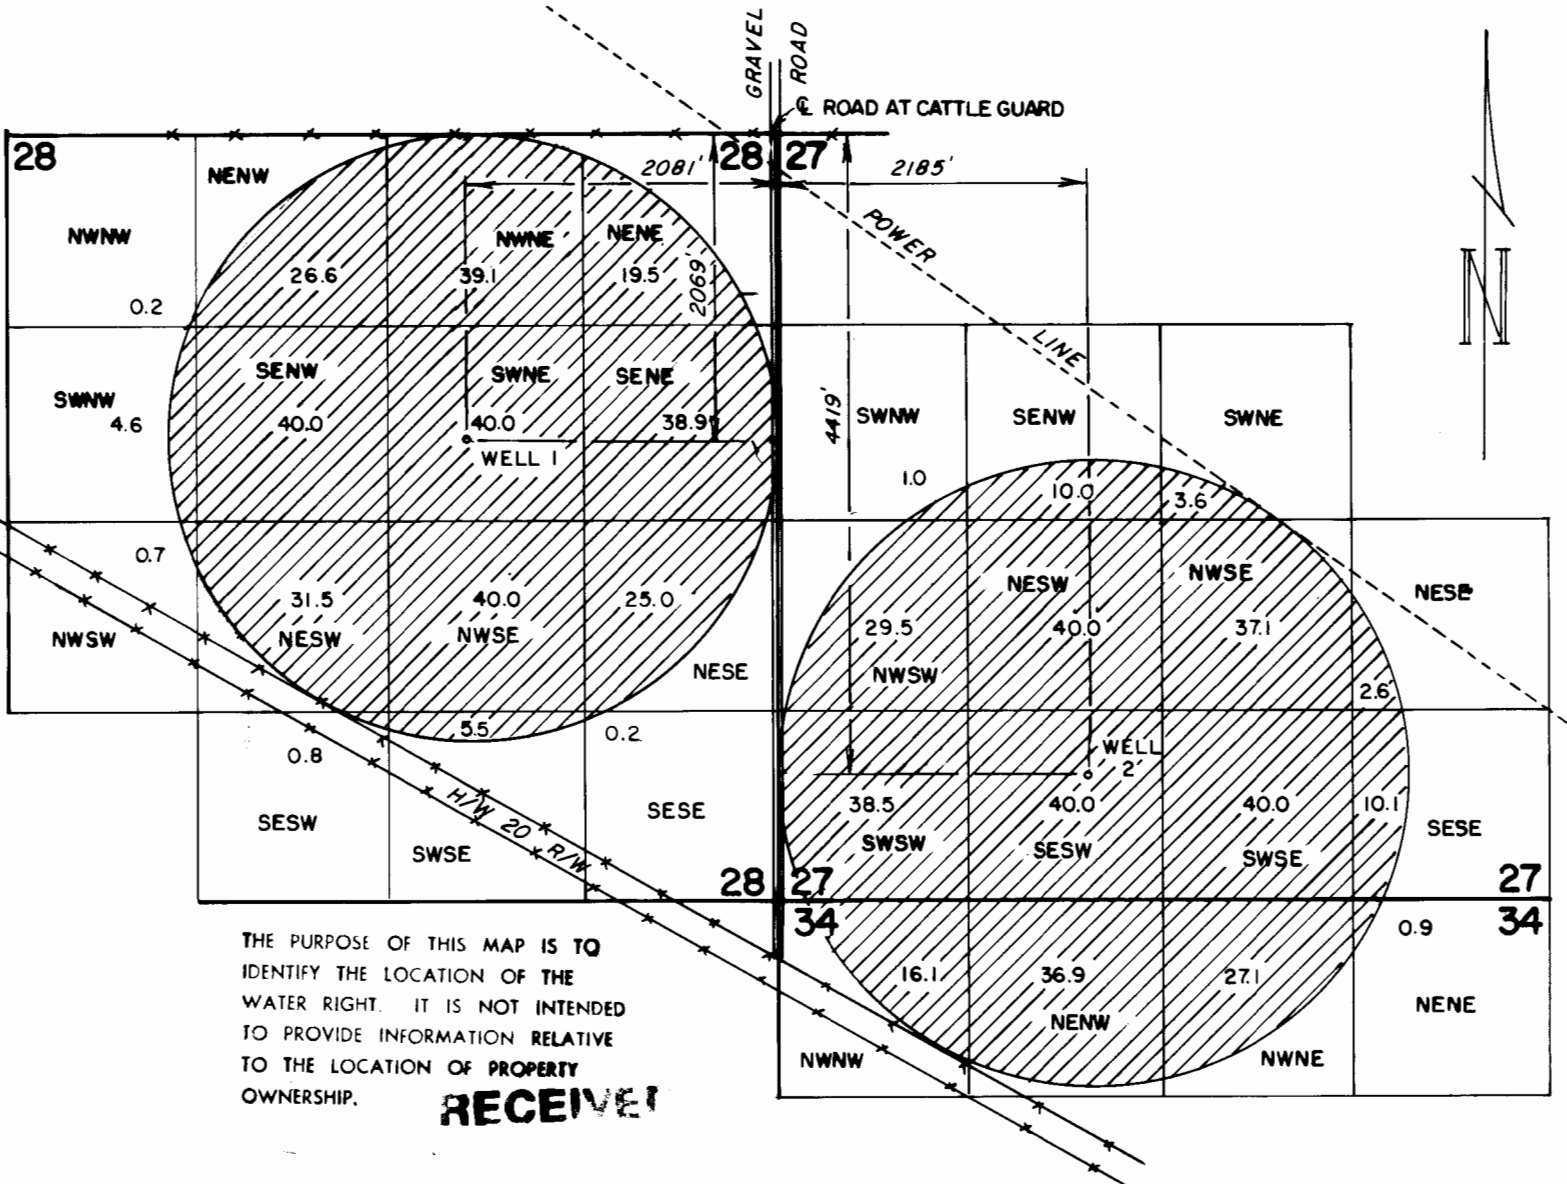

THE PURPOSE OF THIS MAP IS TO IDENTIFY THE LOCATION OF THE WATER RIGHT. IT IS NOT INTENDED TO PROVIDE INFORMATION RELATIVE TO THE LOCATION OF PROPERTY OWNERSHIP.


RECEIVED

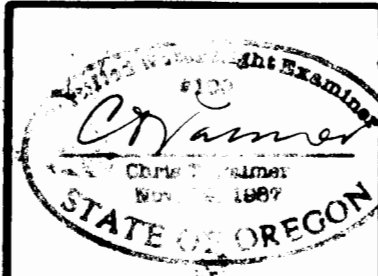

FINAL PROOF SURVEY

UNDER APPLICATION NO. G-12996 PERMIT NO. G-12372

IN THE NAME OF ROBERT L. & JOYCE E. COATS

Scale: 4" = 1 MILE	Date: SEPT. 2000	Job: 1270-A-00
Dsn:	 M. A. PALMER & SONS, INC. ENGINEERING & SURVEYING 254 N. Alder - Box 61 Burns, Oregon 97720	Sht. No.
Drn: CHRIS		of 1
Ckd:		

RENEW 01-01-2001