


CLAIM OF BENEFICIAL USE

T5N, R3W, WM
S 3, Taxlots 101 & 200
COLUMBIA COUNTY, OREGON

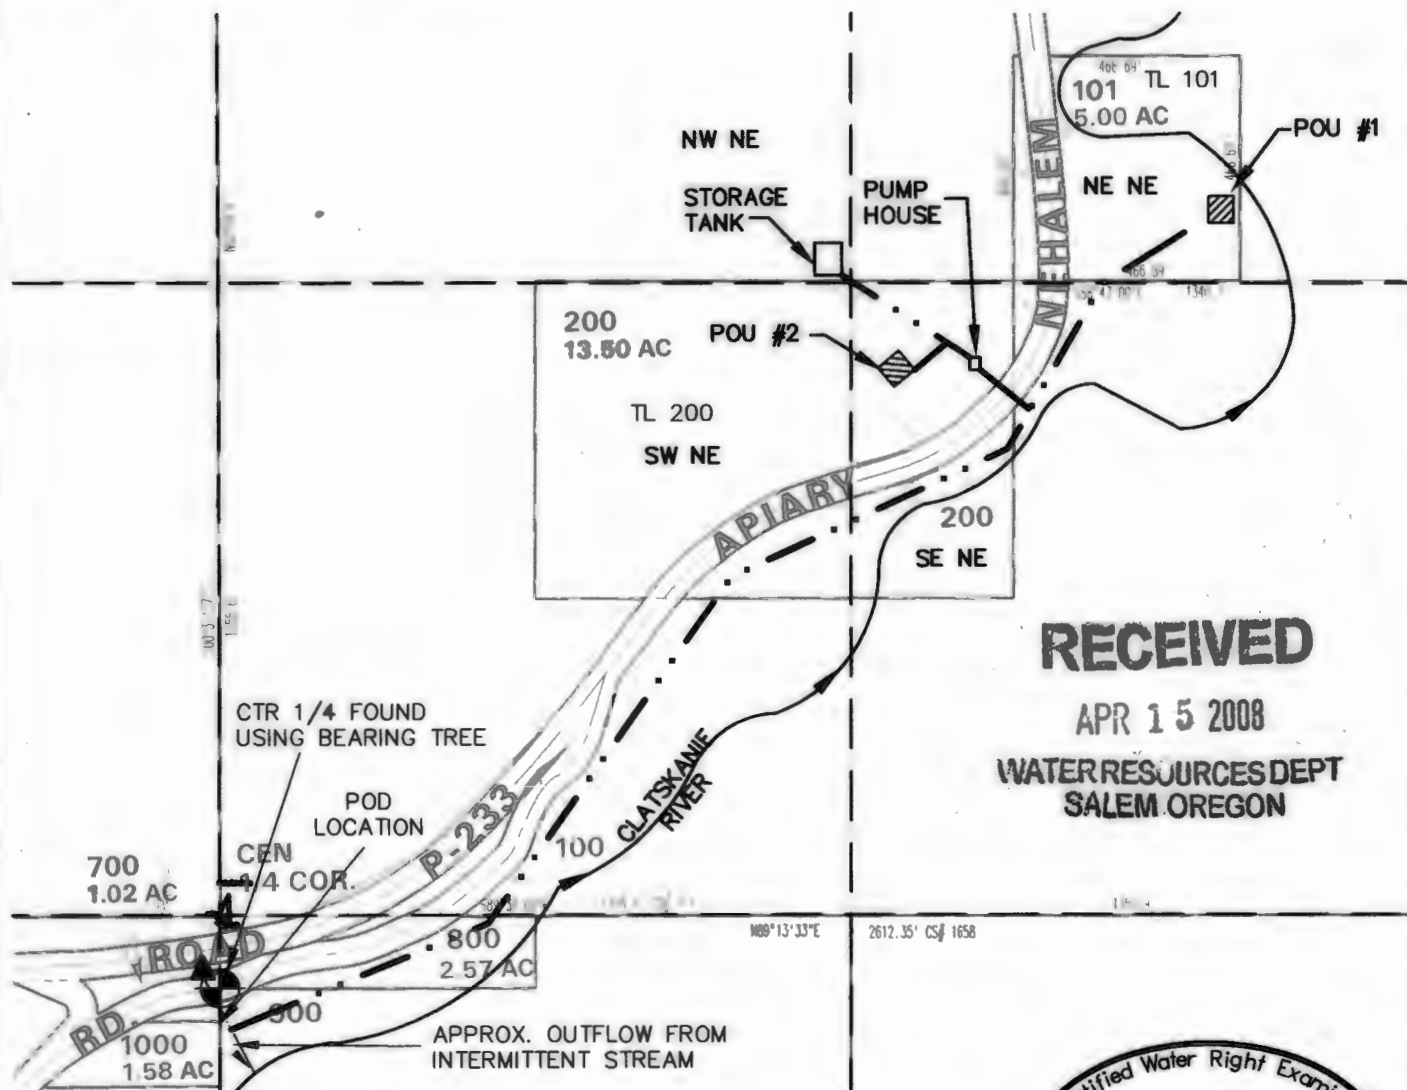

RECEIVED

APR 15 2008

WATER RESOURCES DEPT
SALEM OREGON

▲ POD is N48°W 31' from center 1/4 section 3


▨ PLACE OF USE

--- EXISTING PIPELINE

APPLICATION # S-84457
PERMIT # S-53760



THIS MAP WAS PREPARED FOR THE PURPOSE OF IDENTIFYING THE LOCATION OF A WATER RIGHT ONLY AND IS NOT INTENDED TO PROVIDE LEGAL DIMENSIONS OR LOCATION OF PROPERTY OWNERSHIP LINES.

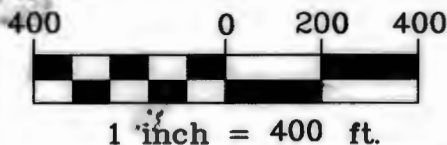

MAP BASE:
ASSESSOR MAP 5N 3 3

Stuntzner
Engineering
& Forestry, LLC

Project: 307-2-126
Drawing: 3072126B-COBU.dwg
By: CVB/EAU
Date: 3-3-08