


CLAIM OF BENEFICIAL USE  
FOR JILL HANSON TRUST  
BY DUANE W. KIRBY  
SW1/4NE1/4 SEC 27 T26S R6W WM  
APPLICATION NO S-86285  
PERMIT NO S-54325  
FISH SCREEN IS LOCATED AT THE POD

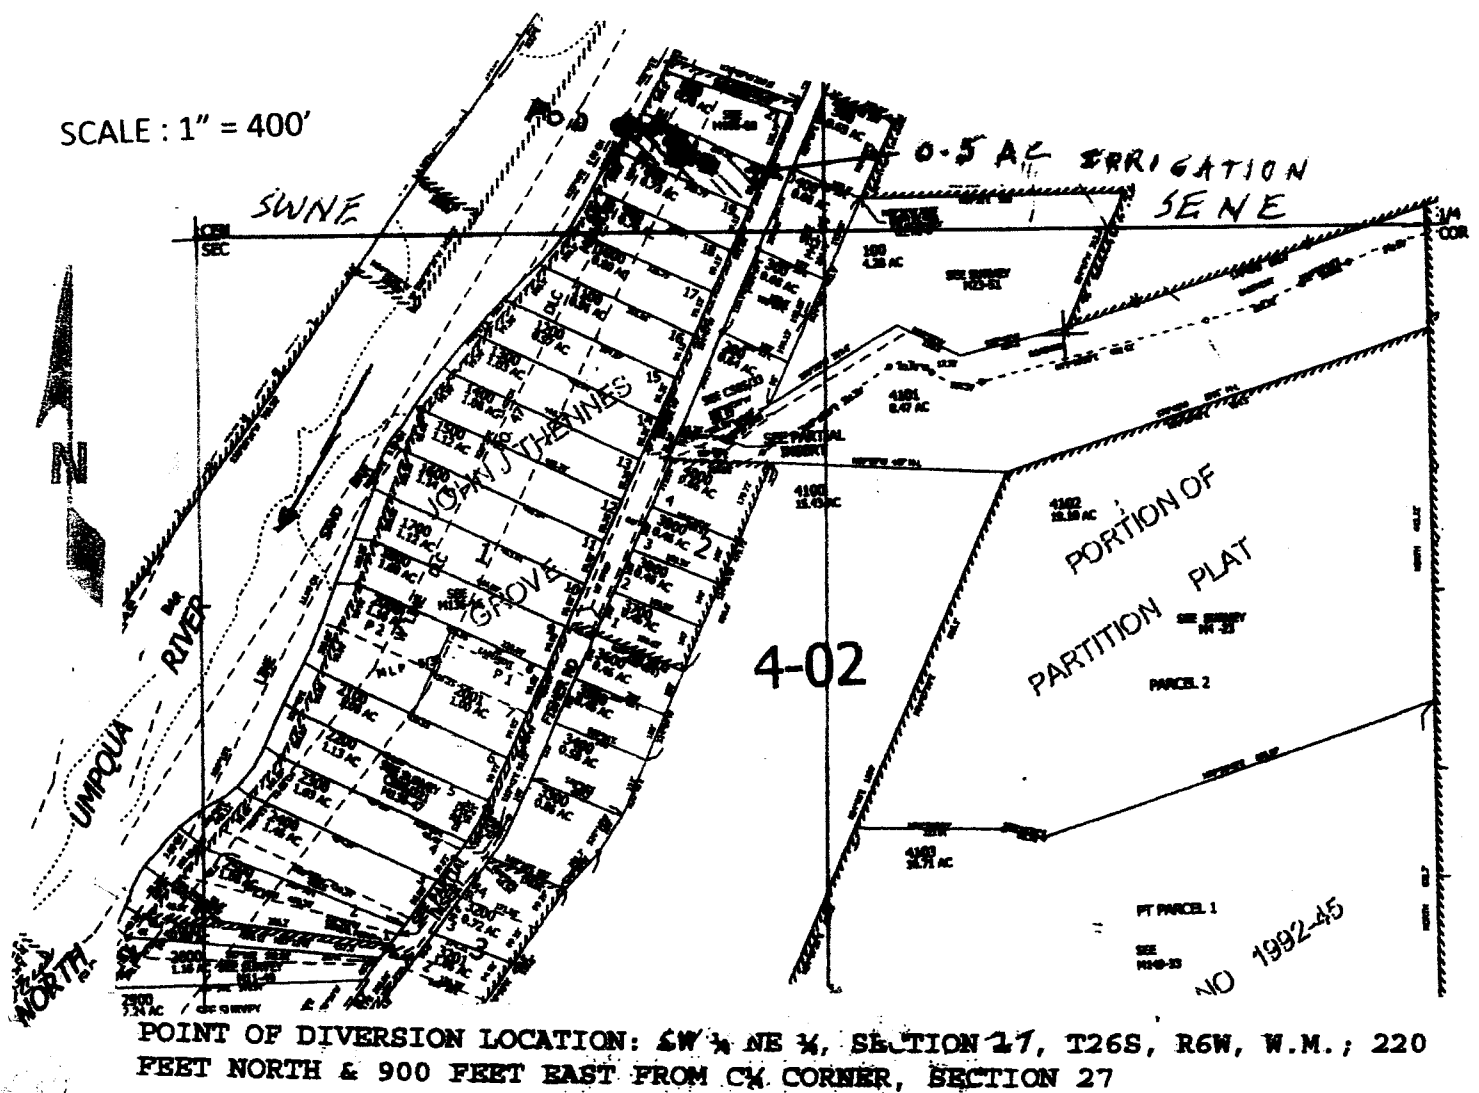

THE PURPOSE OF THIS MAP IS TO IDENTIFY THE LOCATION OF THE WATER RIGHT. IT IS NOT INTENDED TO PROVIDE INFORMATION RELATIVE TO THE LOCATION OF PROPERTY OWNERSHIP BOUNDARY LINES.

