


T. 28 S., R. 12 W., W. M

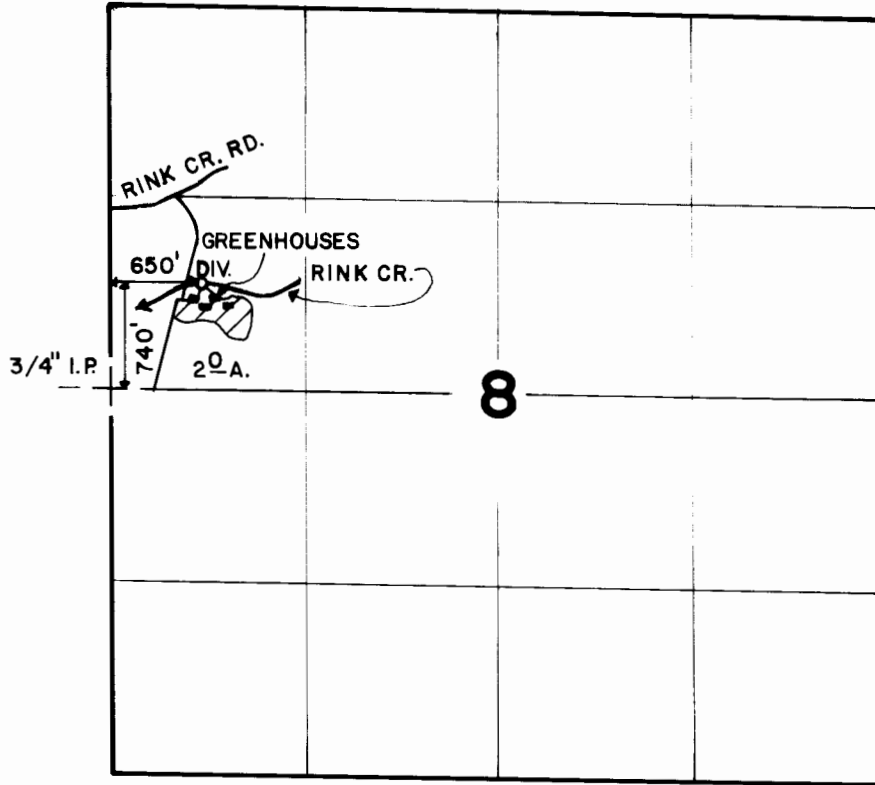

SCALE: 4" = 1 MILE

FINAL PROOF SURVEY UNDER

Application No. 60231 Permit No. 46183
IN NAME OF

WILBUR C. OWEN

Surveyed AUG. 27 1985, by J.M. SCHMORDE