


Claim of Beneficial Use Map for William Oliver
Permit Numbers: R-12807, R-12808, R-12810

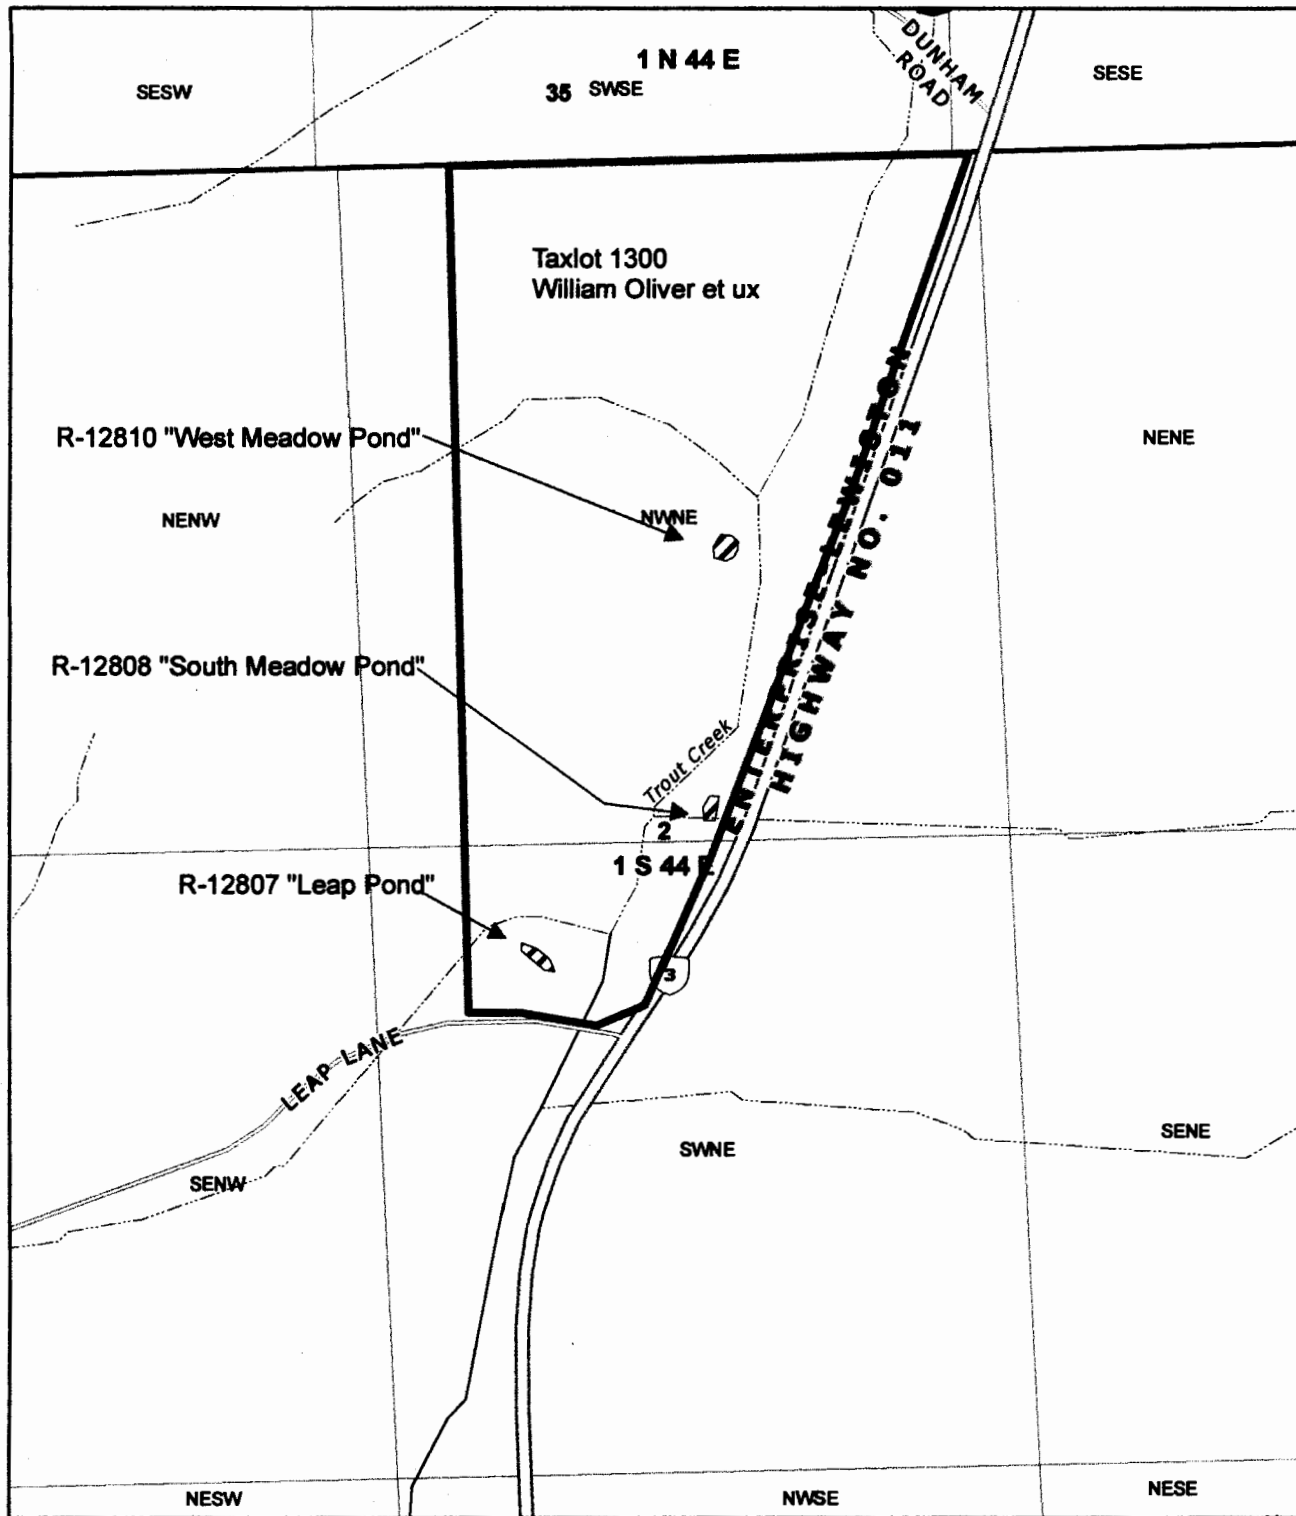

Map Disclaimer:

This product is for informational purposes and may not have been prepared for, or be suitable for legal, engineering, or surveying purposes. Users of this information should review or consult the primary data and information sources to ascertain the usability of the information.

This map is not intended to display property lines

1in=400ft



RECEIVED

FEB 26 2015

Claim of Beneficial Use Map for William Oliver
Permit Numbers: R-12807, R-12808, R-12810



Map Disclaimer:

This product is for informational purposes and may not have been prepared for, or be suitable for legal, engineering, or surveying purposes. Users of this information should review or consult the primary data and information sources to ascertain the usability of the information.

This map is not intended to display property lines

1in=400ft

RECEIVED

FEB 26 2015

WATER RESOURCES DEPT
SALEM, OREGON