


FINAL PROOF SURVEY MAP IN THE NAME OF DAVE COMDEN

APPLICATION S-83851
R-83583 *deb*
R-83972

PERMIT 53569
R-12739
R-12738

SECTION 21, TOWNSHIP 27 SOUTH, RANGE 14 WEST, W.M.

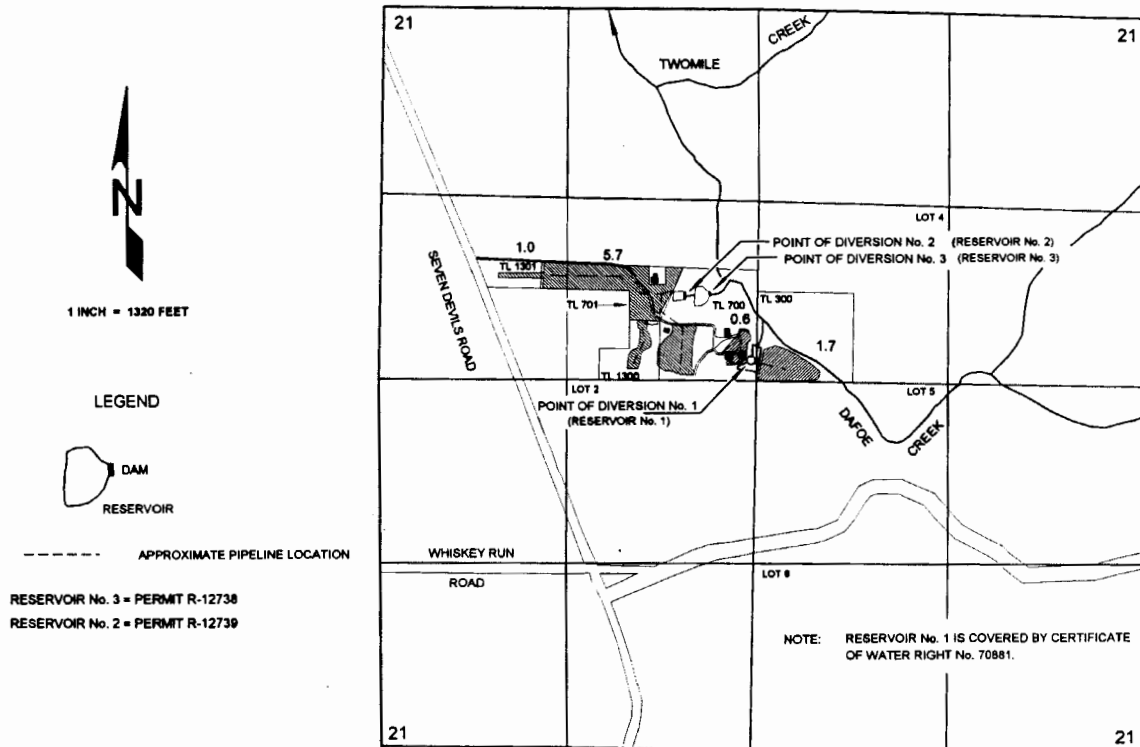



THE POINTS OF DIVERSION ARE LOCATED AS FOLLOWS:

POINT OF DIVERSION No. 1 (PUMP LOCATION) IS 145 FEET NORTH AND 40' WEST;

POINT OF DIVERSION No. 2 (DAM AND PUMP LOCATION) IS 600 FEET NORTH AND 485 FEET WEST;

POINT OF DIVERSION No. 3 (DAM LOCATION) IS 605 FEET NORTH AND 315 FEET WEST; ALL

FROM THE CENTER CORNER OF SECTION 21; BEING WITHIN THE SE $\frac{1}{4}$ NW $\frac{1}{4}$ OF SECTION 21, TOWNSHIP 27 SOUTH, RANGE 14 WEST, W.M.; COOS COUNTY.

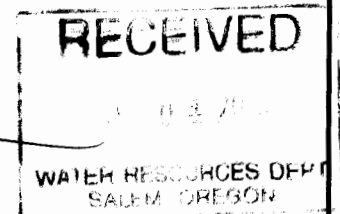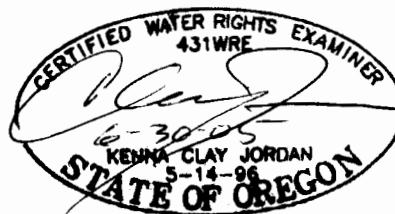

THE PURPOSE OF THIS MAP IS TO SHOW THE LOCATION OF THE WATER RIGHT. IT IS NOT INTENDED TO PROVIDE INFORMATION RELATIVE TO THE LOCATION OF PROPERTY OWNERSHIP BOUNDARY LINES.