


**T26S, R15E
SECTION 15, WM**

LAKE COUNTY, OREGON

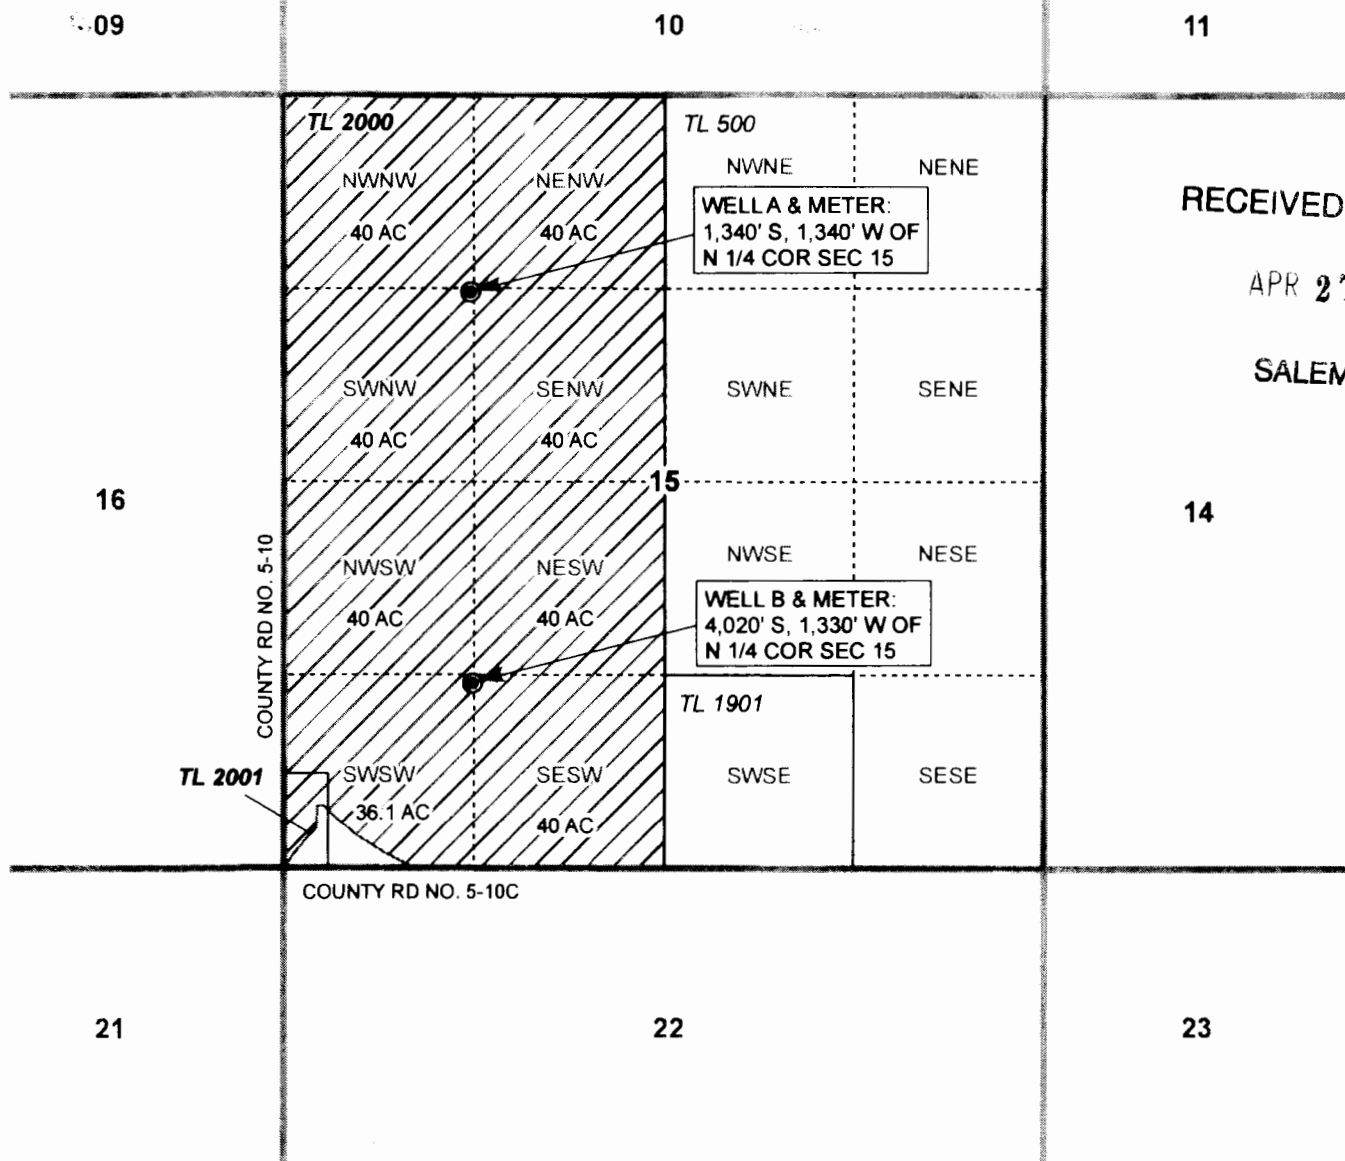

RECEIVED BY OWRD

APR 27 2015


SALEM, OR



0 1,320 Feet

1"=1,320'

- POU Irrigation (320 acres)
- Section
- Quarter Quarter
- Taxlot
- Well

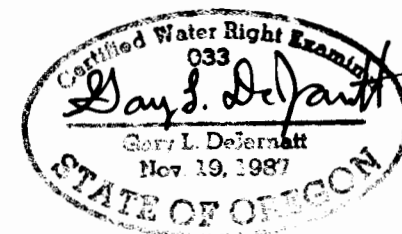

RENEWAL DATE 12/31/2015

CLAIM OF BENEFICIAL USE MAP
Richard Morehouse

APPLICATION G-8609

PERMIT G-7996

NOTE: THIS MAP IS NOT INTENDED TO
PROVIDE LEGAL DIMENSIONS OR LOCATIONS
OF PROPERTY OWNERSHIP LINES.

PROJECT #15012

APRIL 14, 2015

WATER RIGHT SERVICES, LLC
PO BOX 1830, BEND, OR 97709
CCB# 197121 www.oregonwater.us
541-389-2837 JOHNSHORT@USA.COM