


CLAIM OF BENEFICIAL USE MAP

T3N, R1W, SEC 35, W.M.

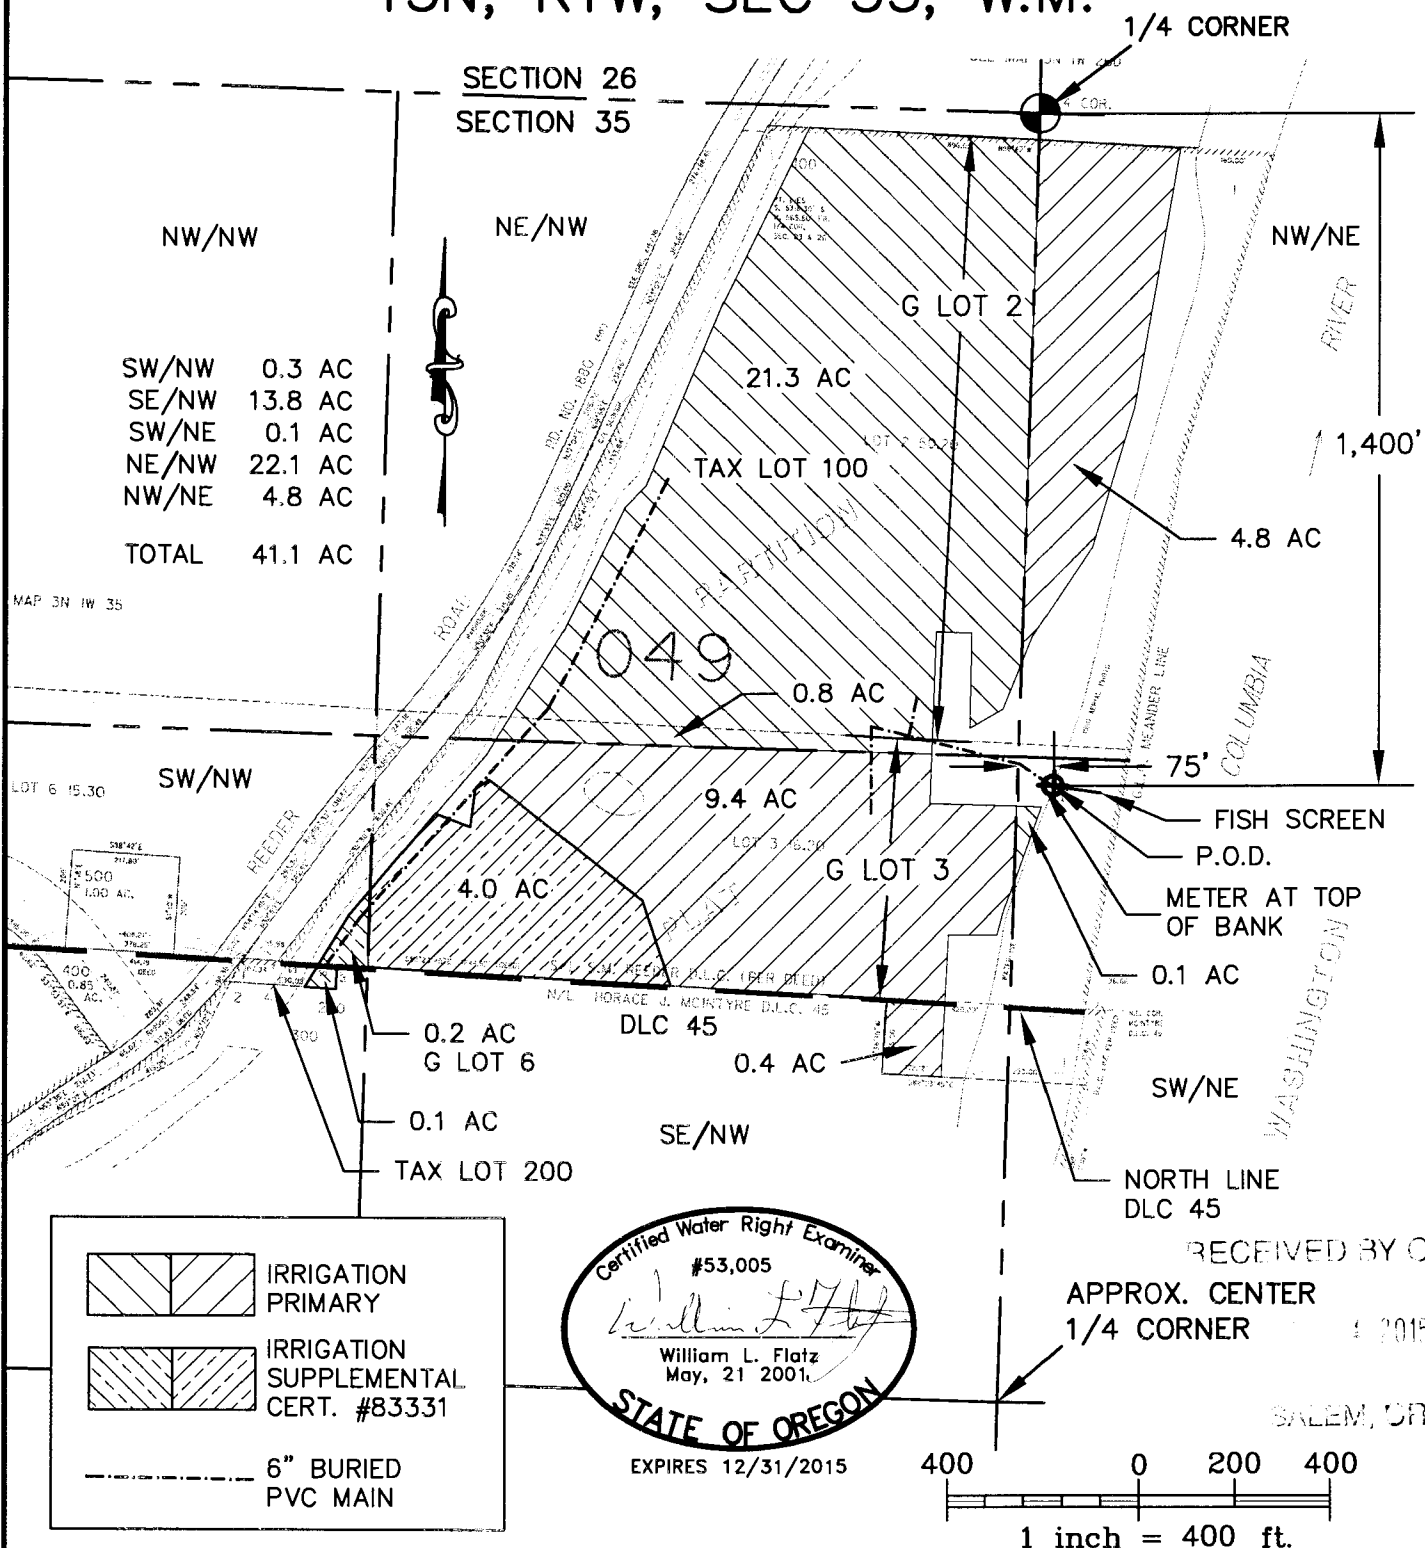

SW/NW	0.3 AC
SE/NW	13.8 AC
SW/NE	0.1 AC
NE/NW	22.1 AC
NW/NE	4.8 AC
TOTAL	41.1 AC

IRRIGATION PRIMARY
 IRRIGATION SUPPLEMENTAL
 CERT. #83331
 6" BURIED PVC MAIN

Certified Water Right Examiner
 #53,005
William L. Flatz
 William L. Flatz
 May, 21 2001
 STATE OF OREGON
 EXPIRES 12/31/2015

UNDER APPLICATION No. S-85017
 PERMIT No. 53286
 IN THE NAME OF: RANDY AND LAURA RUST
 SURVEYED ON SEPTEMBER 20TH 2005
 BY: WILLIAM L. FLATZ

NOTE:
 THIS MAP IS PRODUCED TO CONFIRM THE
 BENEFICIAL USE OF A WATER RIGHT. IT IS
 NOT INTENDED TO PROVIDE INFORMATION
 RELATIVE TO THE LOCATION OF
 PROPERTY LINES.