


Lot 3 Sec 3 Twp 14 SR9

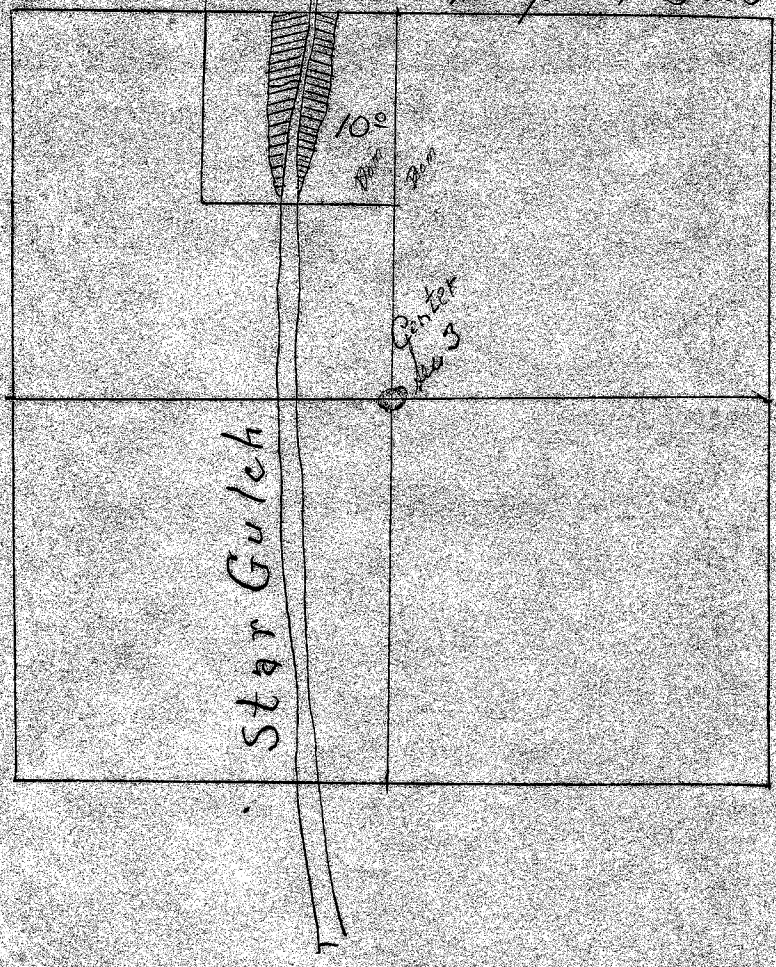

Application No. 10085
Permit No. 8115