

**RECEIVED**


JAN 15 1999

WATER RESOURCES DEPT.  
SALEM, OREGON

T6N, R35E, WM




SCALE = 1" : 500'

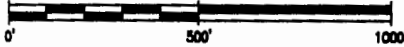

Tax Lot 801  
Section 32, T6N, R35E, WM  
38.9 Acres

Tax Lot 500  
Section 33, T6N, R35E, WM  
40.0 Acres

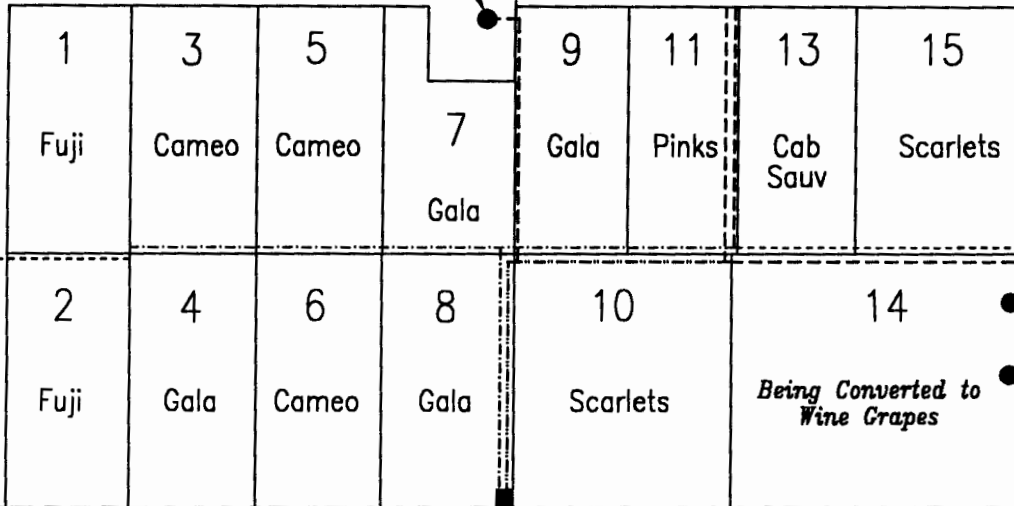

N 0, 20', 59" E

Tax Lot 506

N 41d, 23', 56" W

DIVERSION POINT(S):

WELL 1:

Located 70 feet West and 30 feet South from the NE corner, of the NE 1/4, of the SE 1/4, Section 32, T6N, R35E, WM.

WELL 2:

Located 37 feet West and 660 feet South from the NE corner, of the NW 1/4, of the SW 1/4, Section 33, T6N, R35E, WM.

WELL 4:

Located 37 feet West and 946 feet South from the NE corner, of the NW 1/4, of the SW 1/4, Section 33, T6N, R35E, WM.

32 33

5 4

LEGEND

- 5" PIPE
- 6" PIPE
- 10" PIPE
- 12" PIPE

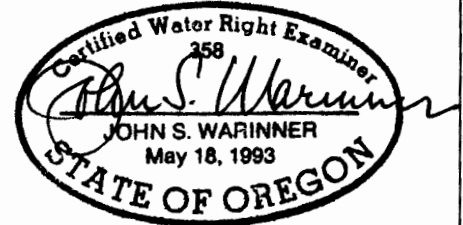


Exhibit A

GENERAL LAYOUT MAP

Application #G-13758

Permit #G-12599

In The Name Of:

McKibben Family Limited Partnership

Surveyed, Jan. 7, 1999, by John Warinner

**Project Name:**  
MFLP  
Walla Walla, WA  
**Project No.** 98-21  
**Date:**  
01-08-99



**Fountainhead  
Irrigation, Inc.**

PO Box 2197 Walla Walla, WA 99362  
Phone (509) 529-2646 Fax (509) 522-5251

RECEIVED


T6N, R35E, WM

JAN 15 1999

WATER RESOURCES DEPT  
SALEM, OREGON



SCALE = 1" = 500'

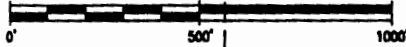

Well 1

Tax Lot 801

COOLING & FROST  
38.9 Acres

Tax Lot 500

COOLING & FROST  
40.0 Acres

Well 2

Well 4

Tax Lot 506

N 0.20', 59° E

N 41.0, 23', 56° W

DIVERSION POINT(S):

WELL 1:

Located 70 feet West and 30 feet South from the NE corner, of the NE 1/4, of the SE 1/4, Section 32, T6N, R35E, WM.

WELL 2:

Located 37 feet West and 660 feet South from the NE corner, of the NW 1/4, of the SW 1/4, Section 33, T6N, R35E, WM.

WELL 4:

Located 37 feet West and 946 feet South from the NE corner, of the NW 1/4, of the SW 1/4, Section 33, T6N, R35E, WM.

32 | 33

5 | 4

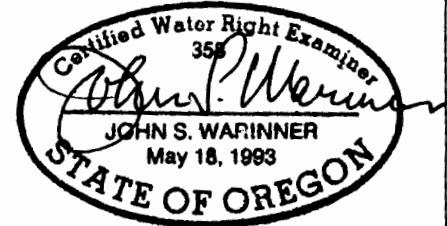


Exhibit B

FINAL PROOF SURVEY

Application #G-13758

Permit #G-12599

In The Name Of:

McKibben Family Limited Partnership  
Surveyed, Jan. 7, 1999, by John Warinner

**Project Name:**  
MFLP  
Walla Walla, WA  
**Project No.** 98-21  
**Date:**  
01-08-99



**Fountainhead  
Irrigation, Inc.**

PO Box 2197 Walla Walla, WA 99362  
Phone (509) 529-2646 Fax (509) 522-5251