

CLAIM OF BENEFICIAL USE

APPLICATION No. G-13970 PERMIT No. G-12820



Sections 29 & 30, T20S, R46E, WM

TAX LOT No. 20-46-D-5100, 5300 & 5800 - MALHEUR COUNTY

FOR: Charles Okano
2580 Norwood Avenue
Nyssa, OR 97913



SCALE: 1" = 1320'

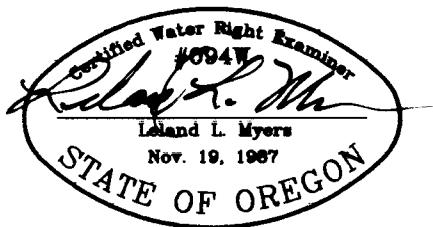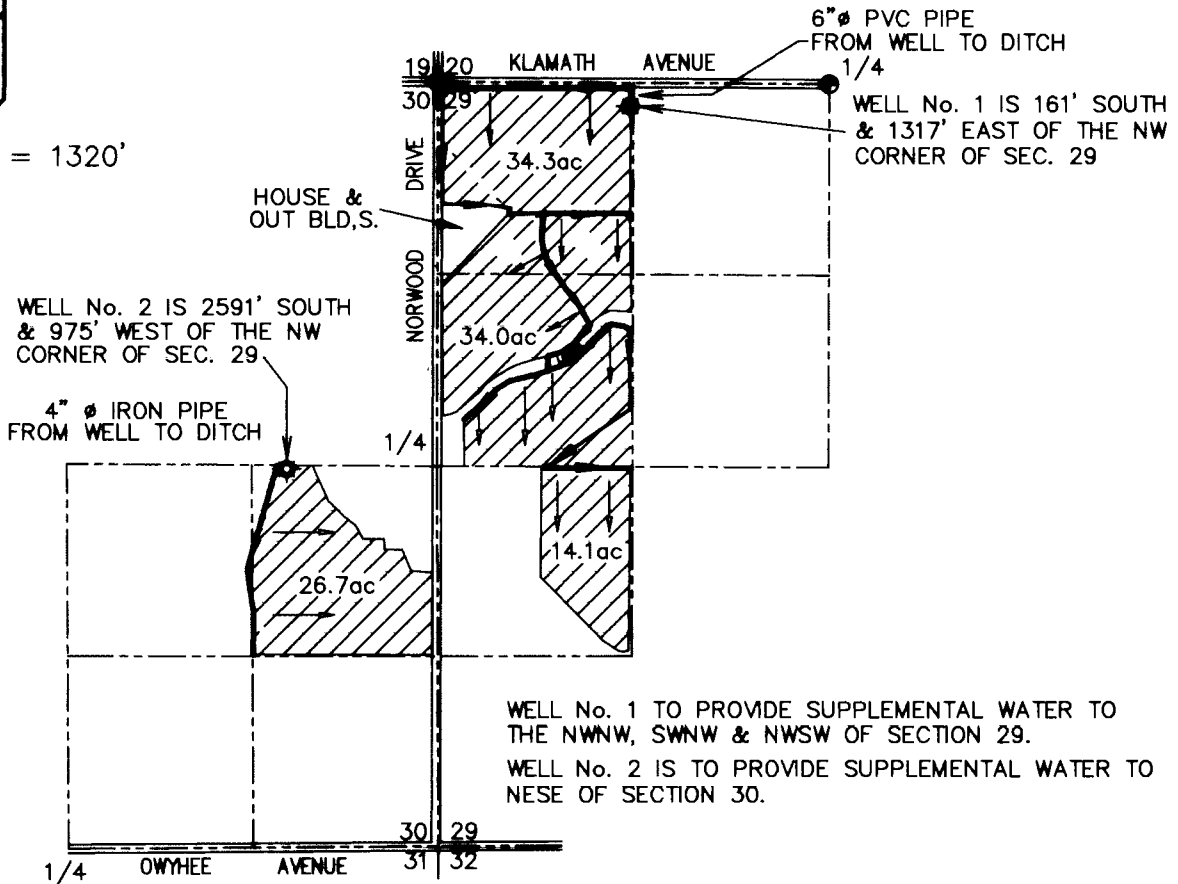

This map is for the purpose of identifying the location of the water right only and has no intent to provide dimensions or location of property ownership lines.

RECEIVED

SEP 29 2000

WATER RESOURCES DEPT
SALEM, OREGON