


Per # 8444
9068

Twp 13 S. R 29 E W1

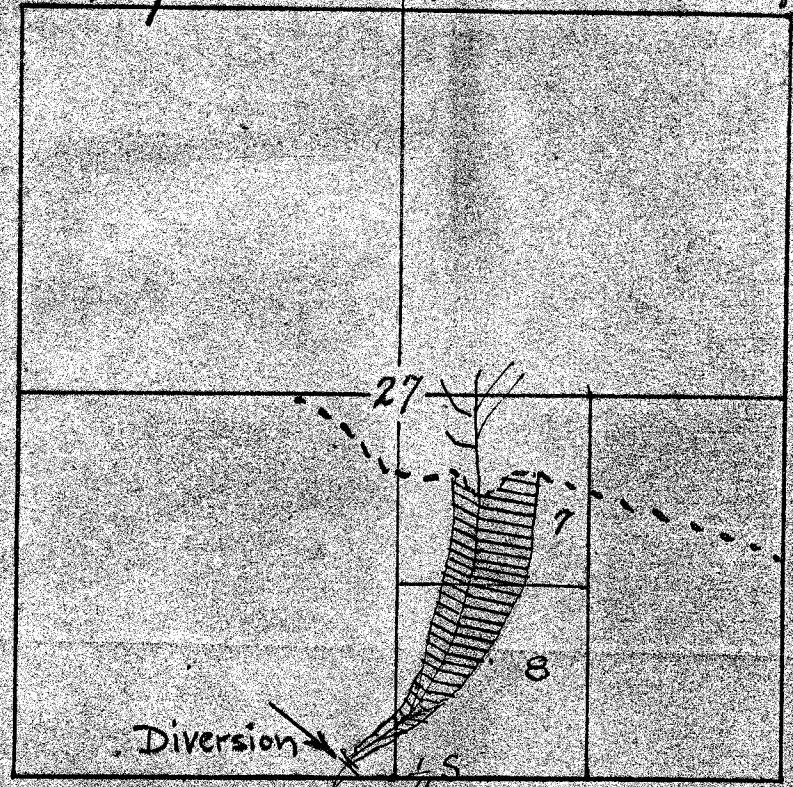

Diversion

Pann Creek

Application No. 12046
Permit No. 8444

1/10/02

