


CLAIM OF BENEFICIAL USE AND SITE REPORT  
 LOCATED IN THE NE¼ SE¼ OF SECTION 1  
 TOWNSHIP 29 SOUTH, RANGE 15 WEST, W.M.  
 COOS COUNTY, OREGON

APPLICATION R-70738 PERMIT R-11786  
 APPLICATION S-70737 PERMIT S-52234

PREPARED FOR: JEFF & PAT KERKER  
 PREPARED BY: DENNIS GOUDE  
 DATE PREPARED: OCTOBER 8, 2004




NOTE:  
 P.O.D. IS LOCATED 20 FEET SOUTH AND 450 FEET  
 WEST OF THE EAST ¼ CORNER OF SECTION 1.  
 P.O.D. IS FOR PERMITS R-11786 & S 52234.

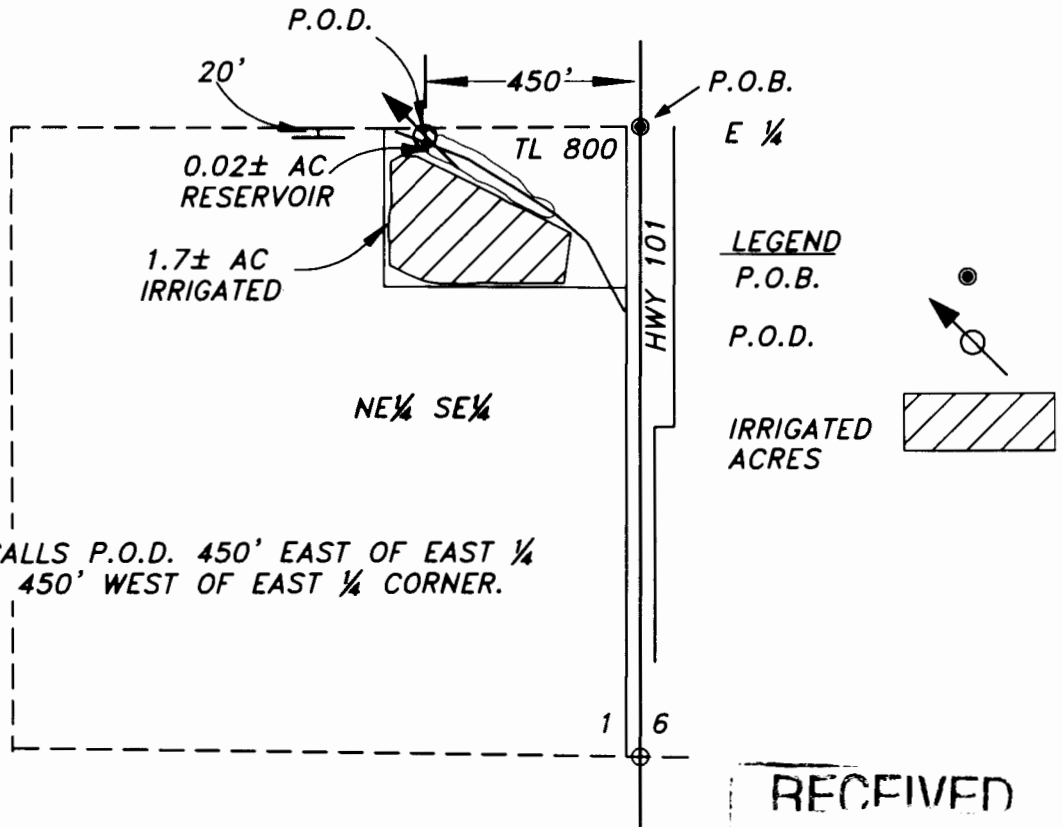

NOTE:  
 PERMIT S 52234 CALLS P.O.D. 450' EAST OF EAST ¼  
 P.O.D IS ACTUALLY 450' WEST OF EAST ¼ CORNER.

RECEIVED  
 FEB 15 2005  
 WATER RESOURCES DEPT  
 SALEM, OREGON

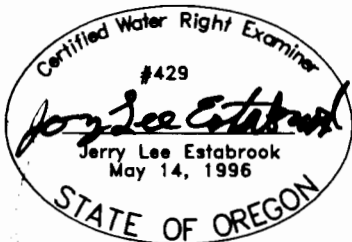

EXPIRES 12/31/2005

**EXAMINERS DISCLAIMER STATEMENT**

The preparation of this map was for the purpose of identifying the location of the Water Right only and has no intent to provide dimensions or location of property ownership lines.

**Stuntzner Engineering & Forestry, L.L.C.**  
 ENGINEERING • LAND SURVEYING • FORESTRY  
 PLANNING • WATER RIGHTS  
 705 South 4th St.  
 Post Office Box 118  
 Coos Bay, Oregon 97420  
 Phone: (541) 267-2872  
 Fax: (541) 267-0588