


420

COBU MAP #0420

SECTIONS 33 TWP. 3 S. RANGE 16 E. W.M.
SHERMAN COUNTY, OREGON

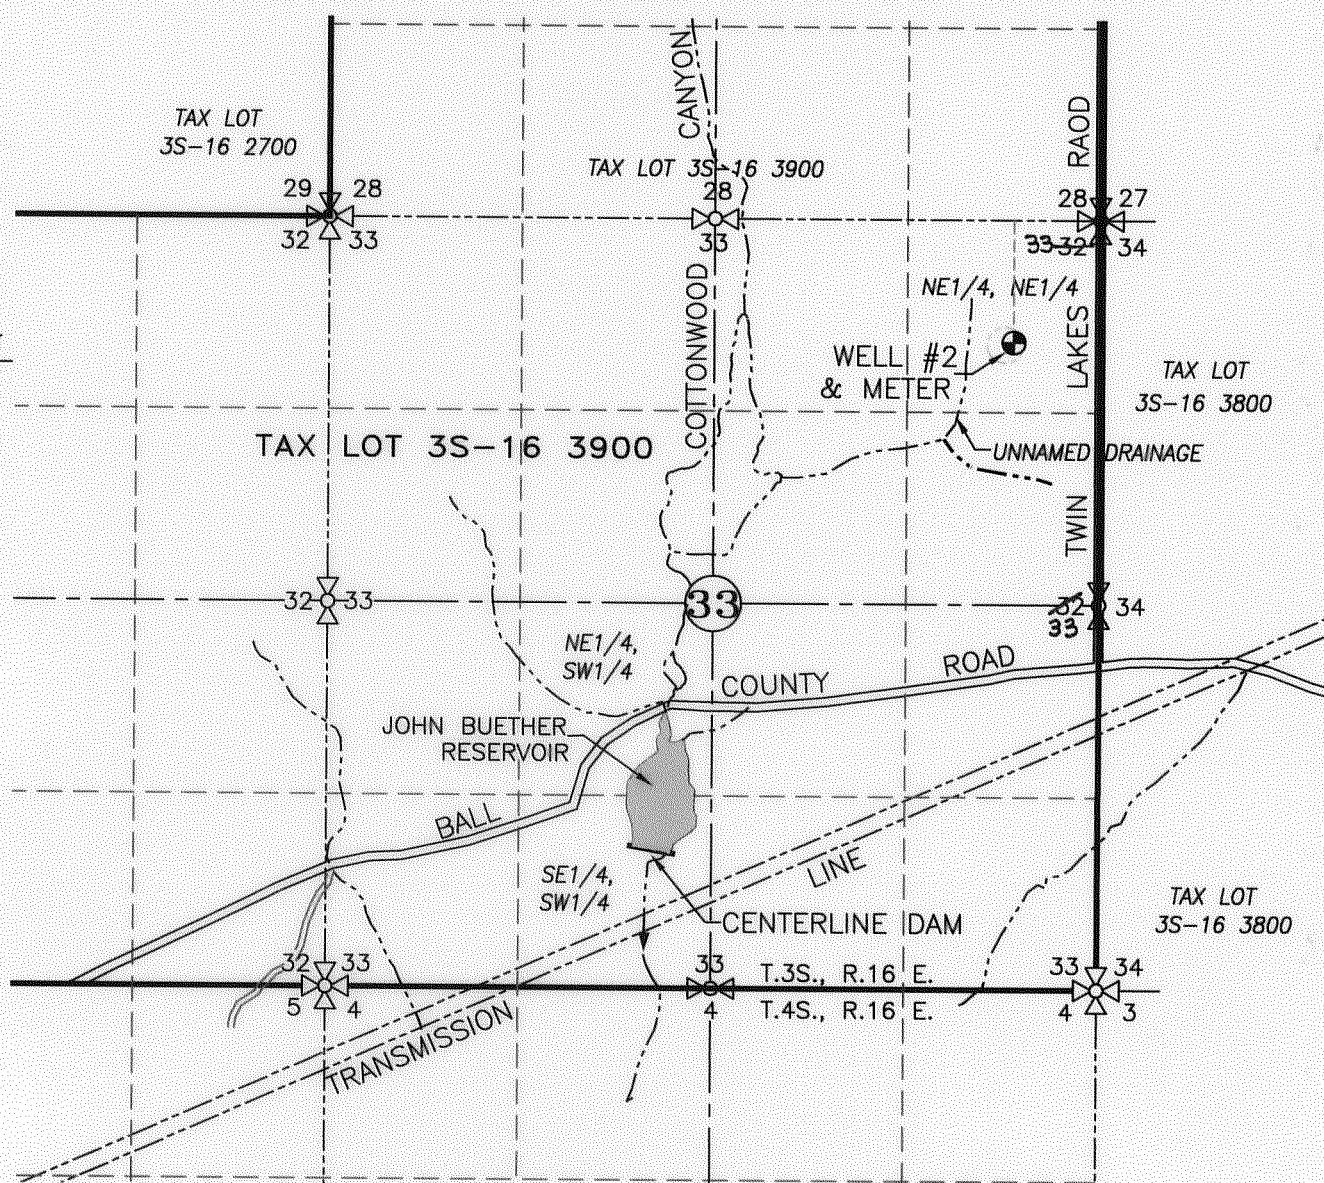

LEGEND:

- ⊕ WELL #2: 840' S. & 590' W. OF NE COR. SECTION 33
- CENTERLINE DAM, 950' N. & 2200' E. OF SW COR. SEC. 33
- JOHN BUETHER RESERVOIR AND DAM
- PIPELINE

RECEIVED

APR 09 2009

WATER RESOURCES DEPT
SALEM, OREGON

WATER RIGHT
CLAIM OF BENEFICIAL USE MAP

SCALE: 1"= 1320'

NOTE: COPIED FROM FINAL PROOF SURVEY FOR APPLICATION R-42194 & APPLICATION G-10879



APPLICATION No. G-15783

PERMIT No. G-15324

IN THE NAME OF:
FRED AND JUDY JUSTESEN

DATE: APRIL 2, 2009

BY: **TENNESON ENGINEERING CORP.**
3313 W. 2ND. STREET, SUITE 100
THE DALLES, OREGON. 97058
PH. (541) 296-9177
FAX (541) 296-6657

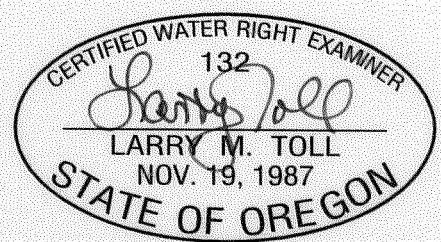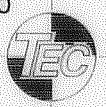

EXPIRES: 06/30/2010

NOTE:
"THIS MAP IS NOT INTENDED TO
PROVIDE DIMENSIONS OR LOCATIONS
OF PROPERTY OWNERSHIP LINES."

W.O. #13068wr