


FOR: JAMES AND LAURETTE FRASNELLY
 BY: DUANE W. KIRBY
 T26S,R6W,W.M., SEC 23
 APPLICATION NO. S-86247
 PERMIT NO. S-54250
 TAX LOT 1100
 SCALE: 1" = 400'
 FISH SCREEN IS AT POD

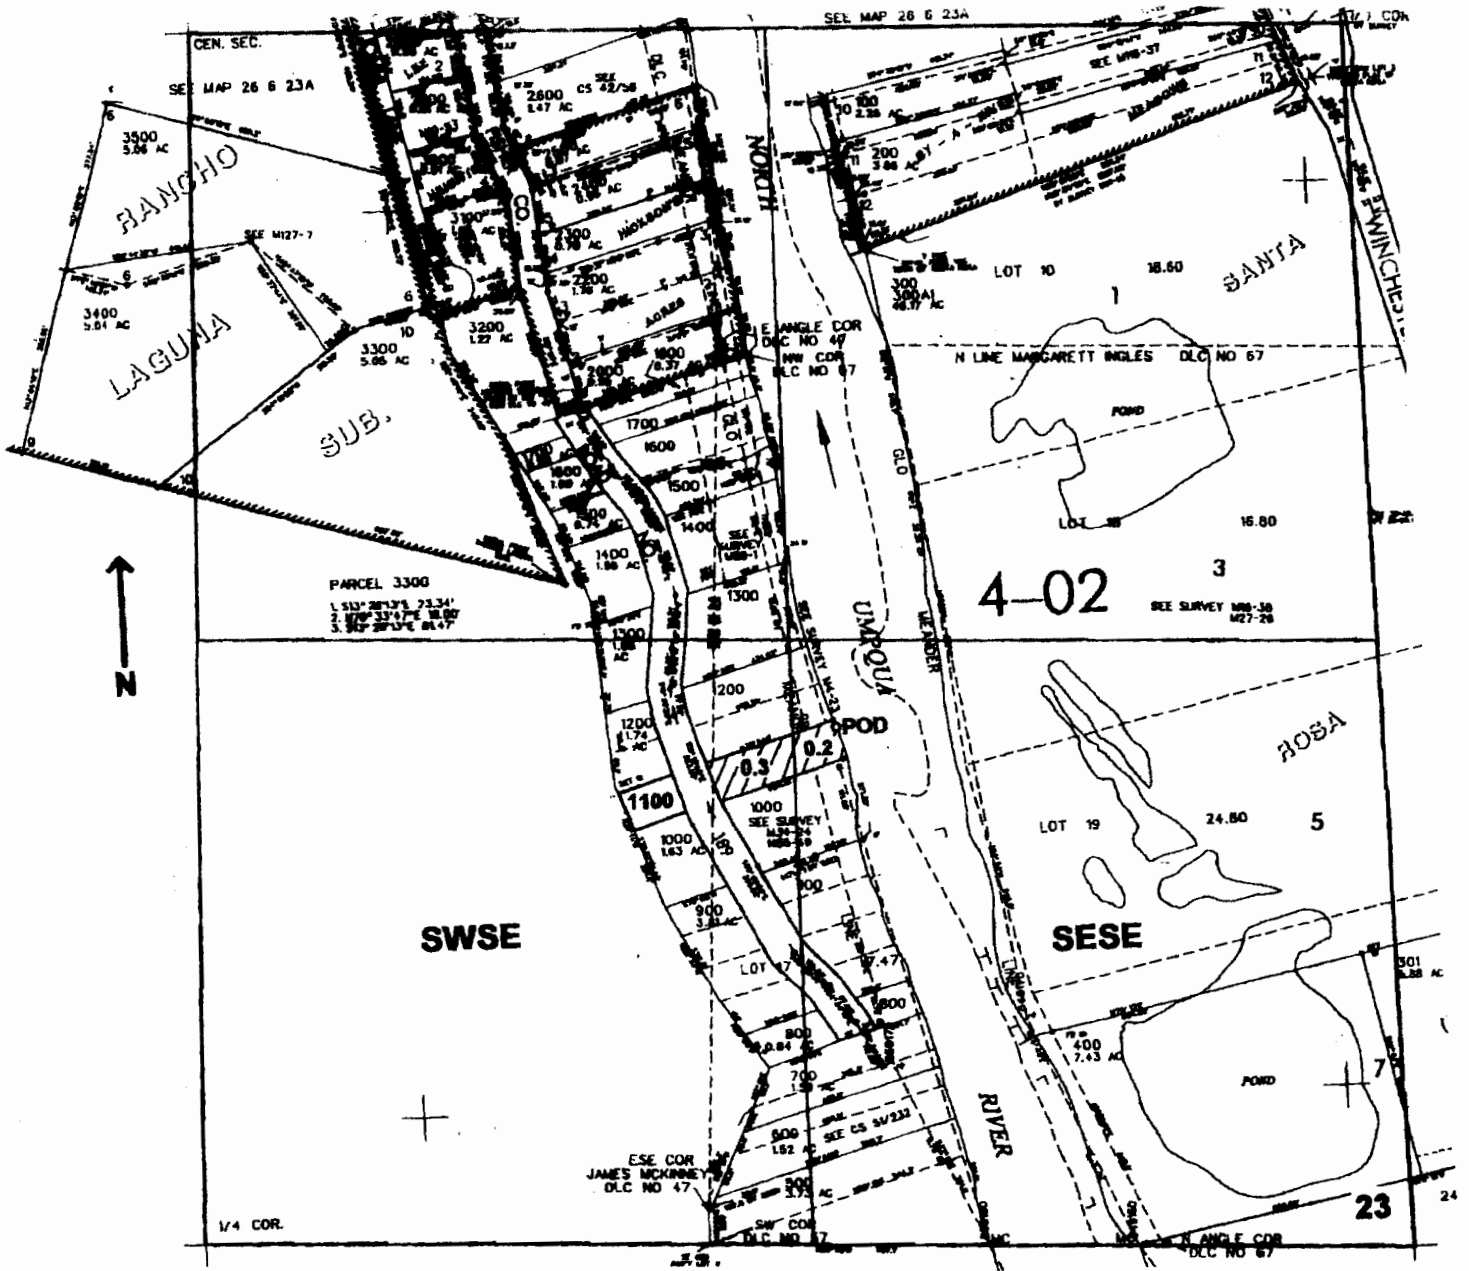

POD is located 1150 ft. N. and 1200 ft. W. from the SE corner of Sec. 23

THE PURPOSE OF THIS MAP IS TO IDENTIFY THE LOCATION OF THE WATER RIGHT. IT IS NOT INTENDED TO PROVIDE INFORMATION RELATIVE TO THE LOCATION OF PROPERTY OWNERSHIP BOUNDARY LINES.

