


WATER RIGHTS FINAL PROOF MAP
 Located in the SW $\frac{1}{4}$ NW $\frac{1}{4}$ of Section 14,
 Township 41 South, Range 13 West, Willamette Meridian
 Curry County, Oregon
 Application S-85103 Permit 53904


Prepared For: HW3, LLC ET AL
 Prepared By: Dennis Goude
 Date Prepared: February 4, 2009

NOTE:

The P.O.D. is located 348 feet North and 49 feet East of the West $\frac{1}{4}$ corner of Section 14, Township 41 South, Range 13 West, W.M.

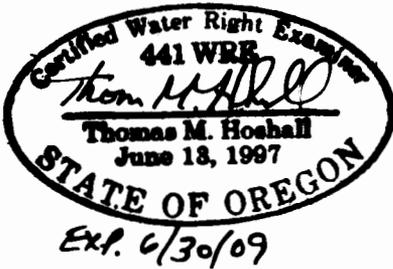

The P.O.D. is a 3 foot diameter 10 foot deep cistern with a $\frac{1}{2}$ HP pump. 330 feet of 1 inch diameter PVC pipe connects to the place of use.

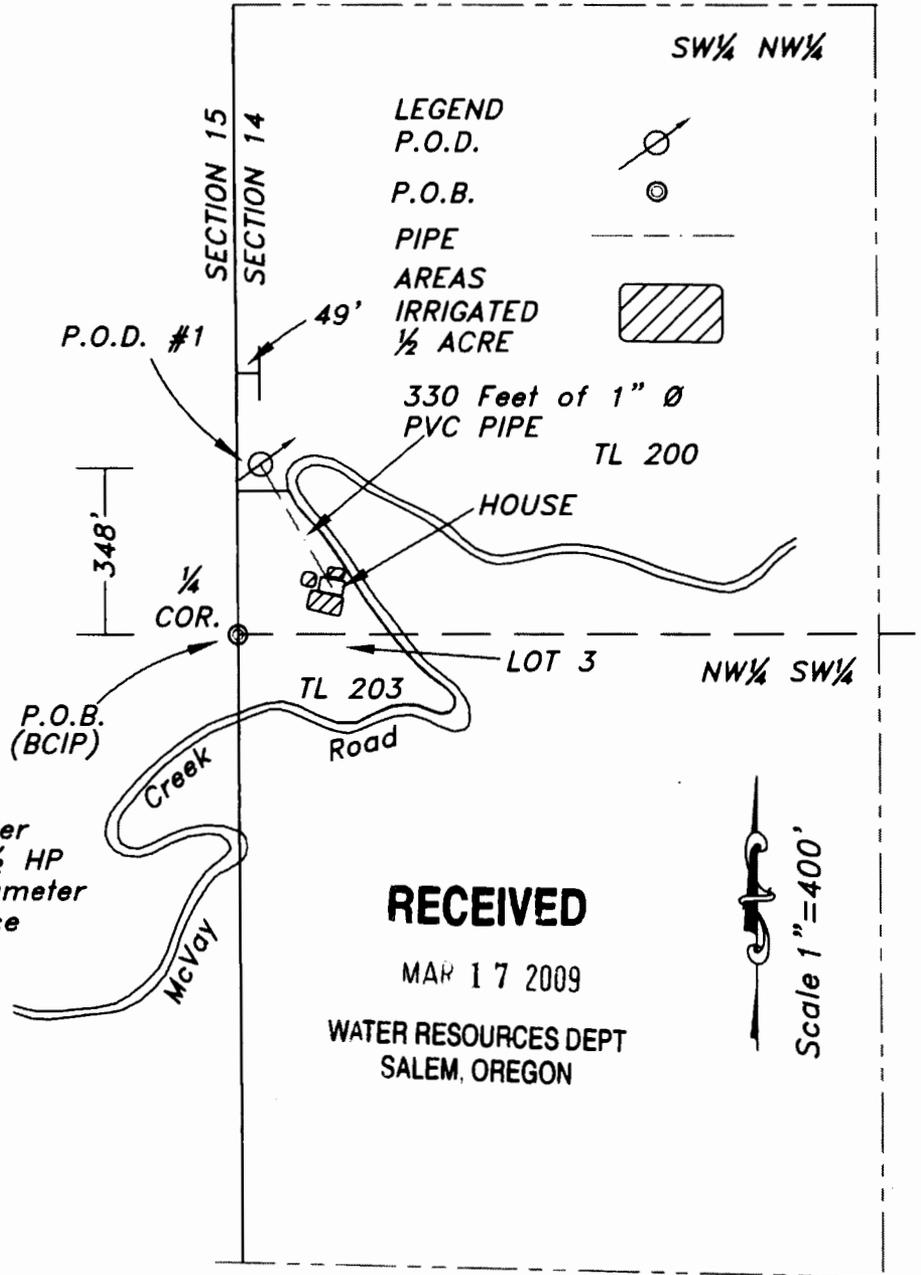

Stuntzner Engineering & Forestry, L.L.C.
 ENGINEERING • LAND SURVEYING • FORESTRY
 PLANNING • WATER RIGHTS
 706 South 4th St.
 Post Office Box 116
 Coos Bay, Oregon 97420
 Phone: (541) 267-2872
 Fax: (541) 267-0588

| | |
|-------------------------|------------------------|
| Drawn By: Dennis Goude | Date: Feb. 4, 2009 |
| Checked By: Tom Hoehall | Drawing No.: 209-3-003 |
| Design By: | Revised: |
| Job #: | HW3, LLC ET AL |

Sheet 1 of 1

EXAMINERS DISCLAIMER STATEMENT

The preparation of this map was for the purpose of identifying the location of the Water Right only and has no intent to provide dimensions or location of property ownership lines.