



FINAL PROOF SURVEY MAP IN THE NAME OF WILLIAM & SANDRA DeJONG

Application G-13387 Permit G-12465

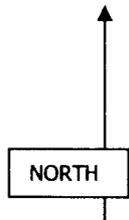

T 39 S R 12 E, W.M.
Sections 27 and 28

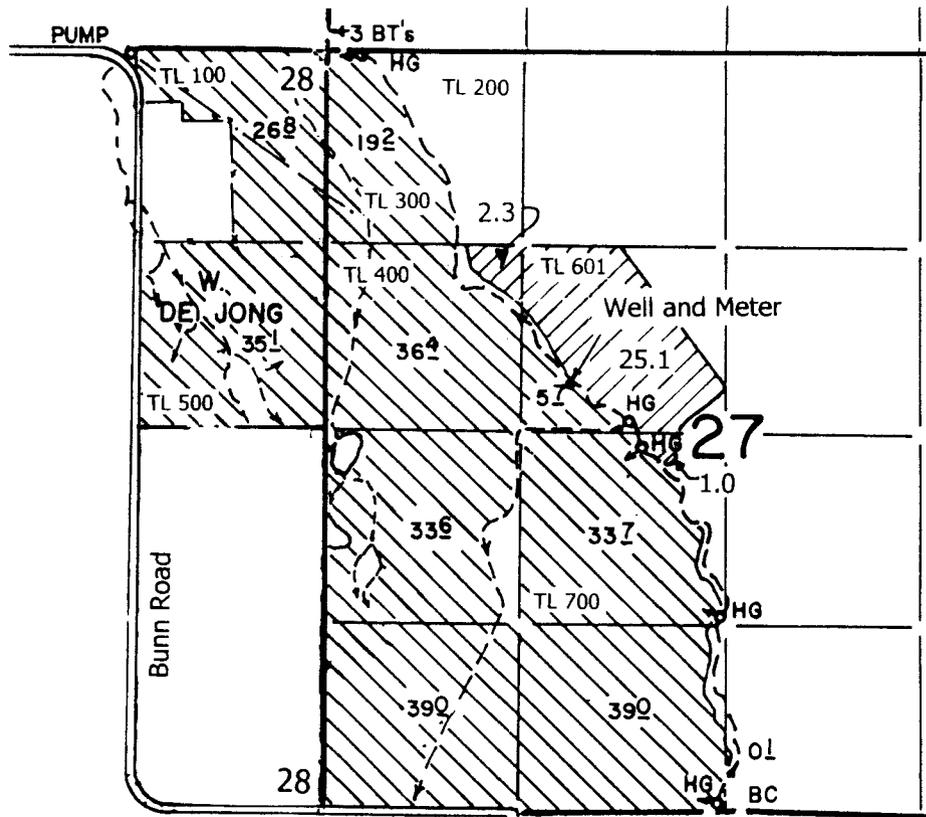

 supplemental  primary

WELL: 2950' N & 1060' W of the S 1/4 corner section 27

Scale 4" = 1 MILE

This map is for water
right purposes only.

