

FINAL PROOF SURVEY MAP


T 5 S R 1 W sections 21 & 22

RECEIVED

SEP 15 2005


**WATER RESOURCES DEPT
SALEM, OREGON**

Prepared for: Fessler Family, LLC
application G-15560 permit G-15172

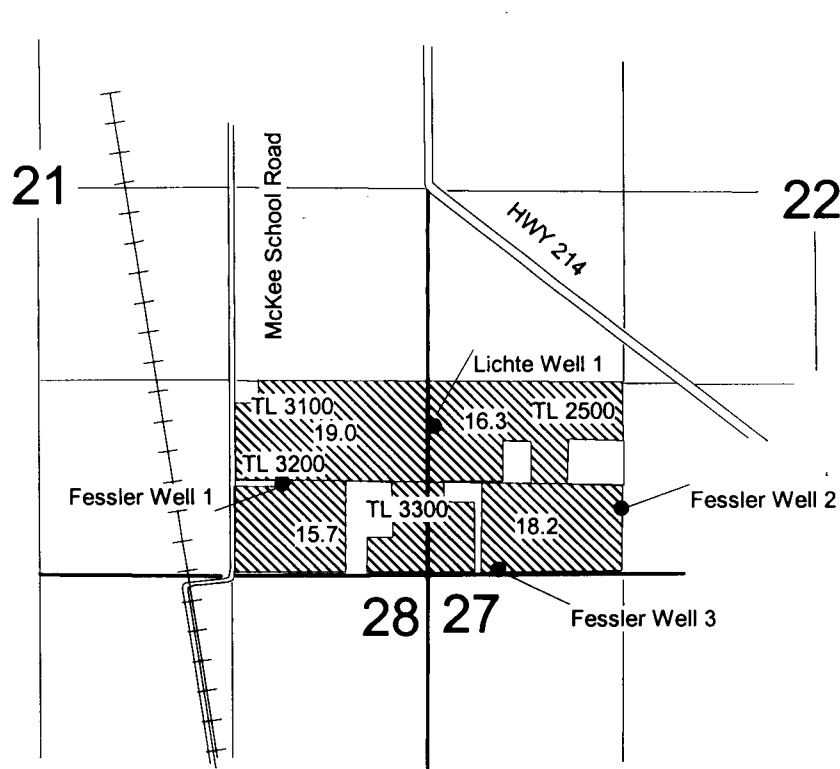

Lichte Well 1: 1040' N & 20' E
Fessler Well 1: 630' N & 1000' W
Fessler Well 2: 550' N & 1290' E
Fessler Well 3: 20' N & 460' E
all from the SW corner Section 22
(All wells have measuring devices at well site.)

1" = 1320'

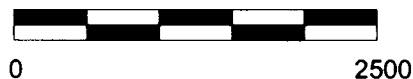

This map is for water
right purposes only.

