



T.2S.,R.22E.,W.M.

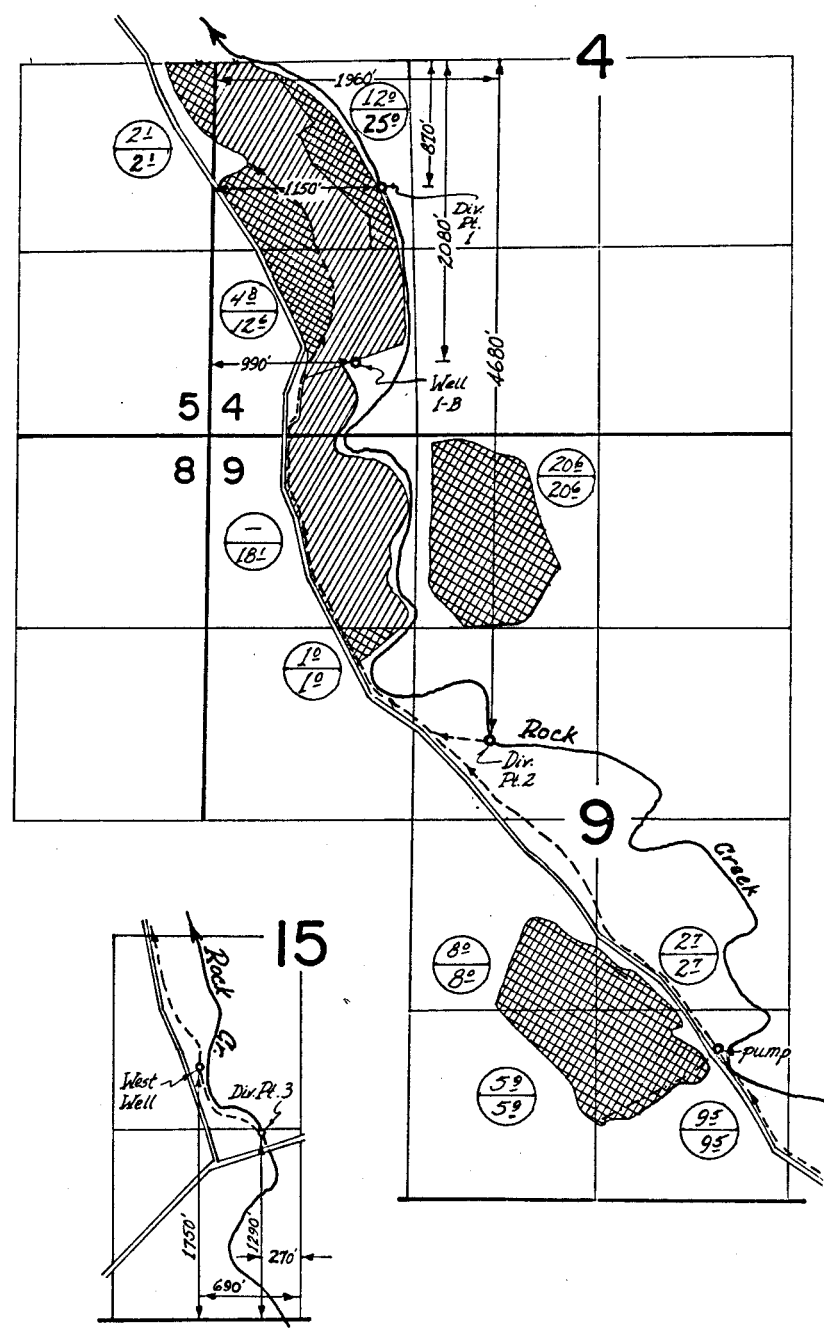

FINAL PROOF SURVEY UNDER

53596 39932
 Application No. G-6926 Permit No. G-6444
 IN NAME OF

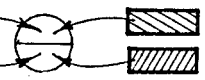

LEE & PATRICIA PETTYJOHN

Surveyed Oct. 26, 1977, by R.G. Mucken