



Claim of Beneficial Use
Final Proof Survey Map
Thomas and Sherry Hammett
Application R-84343
Permit R-12910
Douglas County
Scale 1" = 400'

RECEIVED BY OWRD

FEB 09 2015

SALEM, OR

T.27S R.7W Sections 25 and 36

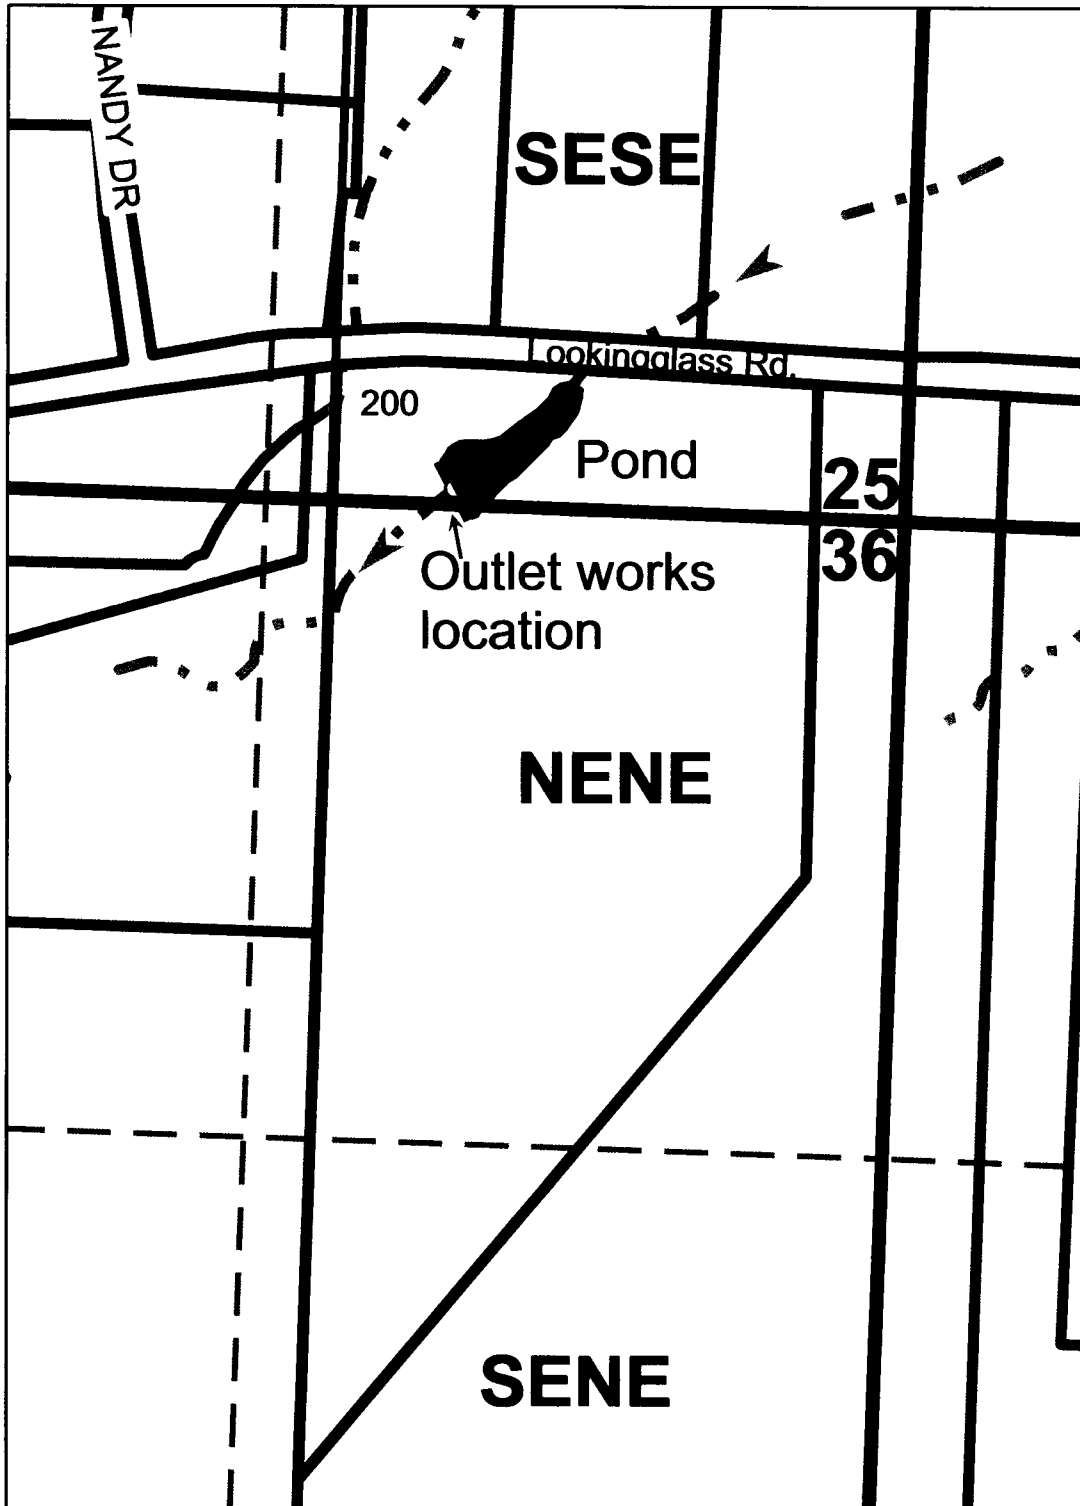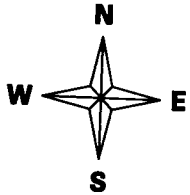

Dam location is 28 ft. north and 940 ft. west from the
NE corner of Section 36

SEC. 36 T.27S. R.7 W W.M.
DOUGLAS COUNTY


1"=400'

REVISED ON
12-28-98

27 7 36
& INDEX

SE 1/4, SE 1/4
SEE MAP 27 7 25

SEE MAP 27 7 25D

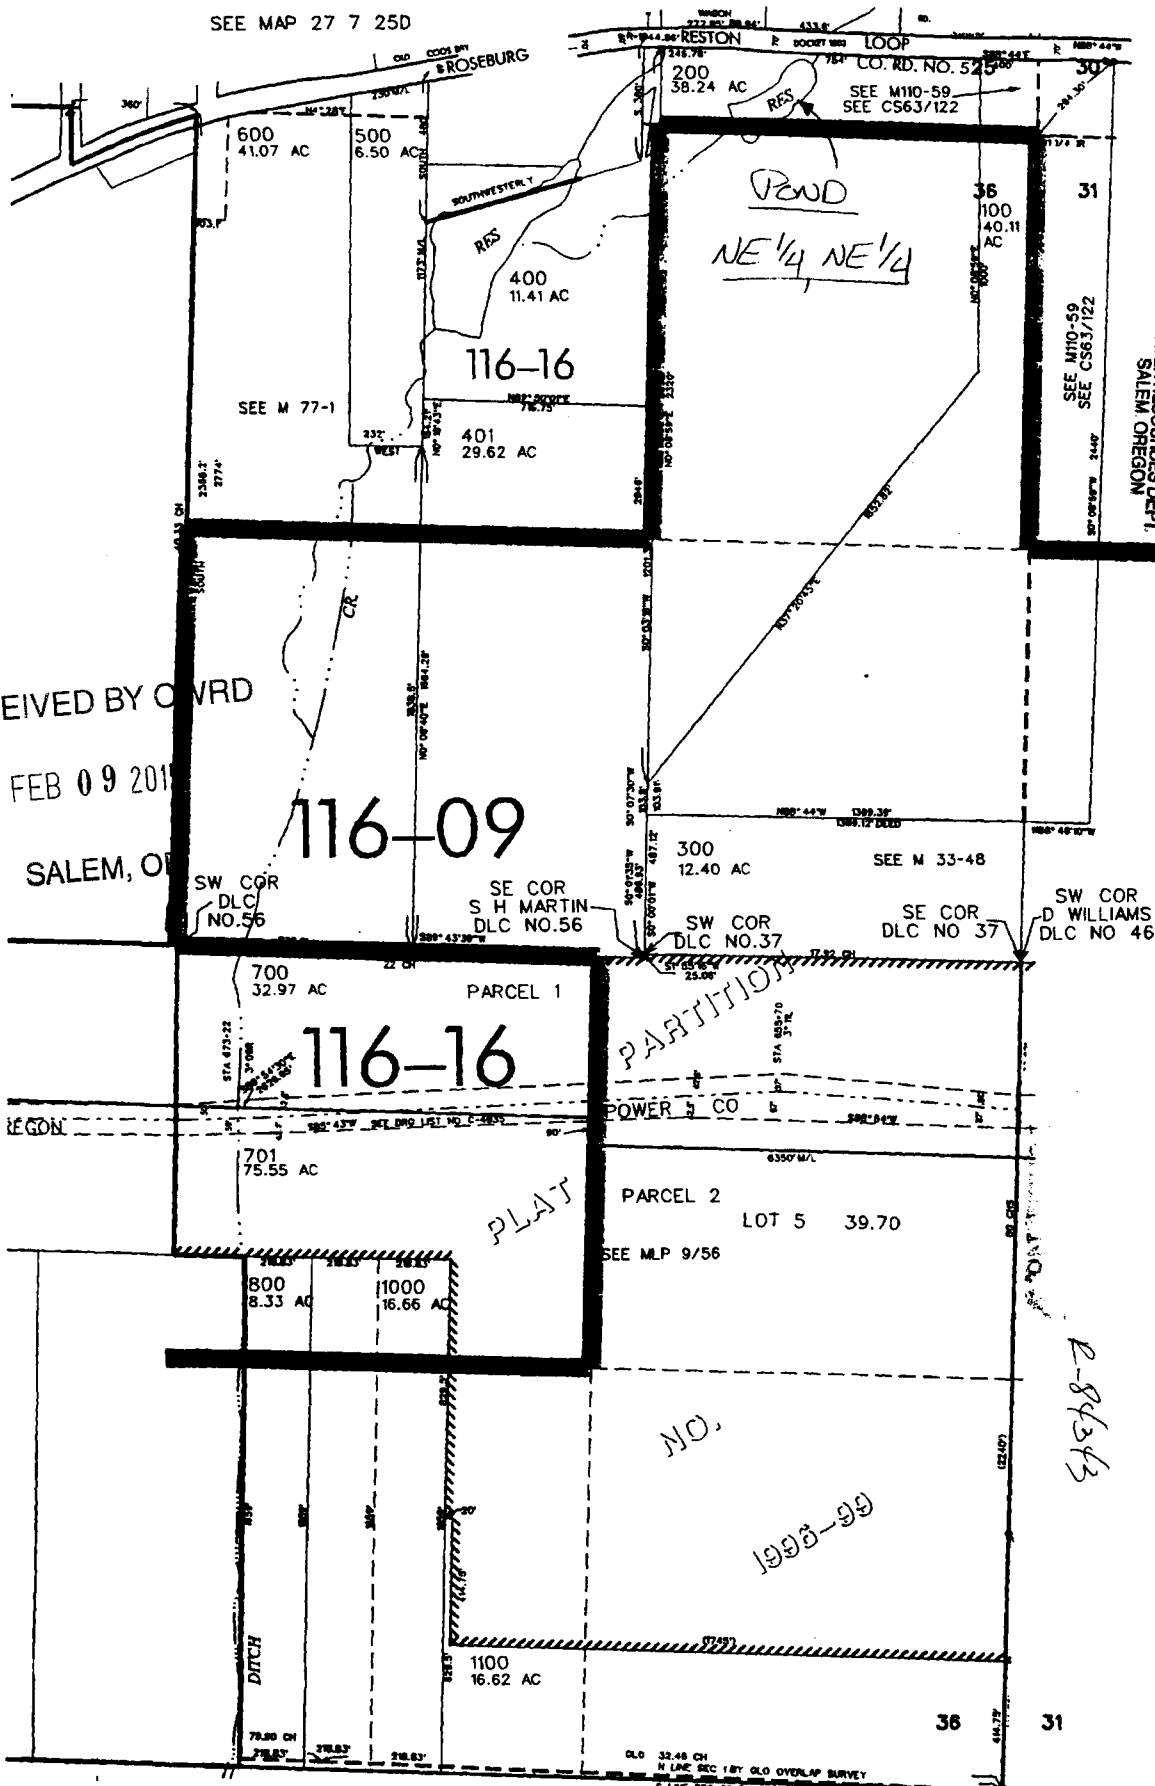

CANCELLED NO'S
900 300MI

WATER RESOURCES DEPT.
SALEM OREGON

FEB 18 2000

RECEIVED

RECEIVED BY OVRD

FEB 09 2001

SALEM, OR

116-09

SW COR
DLC
NO.56

SE COR
S H MARTIN
DLC NO.56

SW COR
DLC NO.37

SE COR
DLC NO 37

SW COR
D WILLIAMS
DLC NO 46

116-16

PARCEL 1

PARTITION

POWER & CO

PARCEL 2

LOT 5 39.70

SEE M.L.P 9/56

PLAT

800
8.33 AC

1000
16.66 AC

1100
16.62 AC

36

31

SEE MAP 27 6 31

RECEIVED BY OW

FEB 14 2001

SALEM, OR

2-84343

0001